

STONE
 C 2020
 7-14-77

MISSISSIPPI
 BOARD OF WATER COMMISSIONERS
 416 North State Street
 130 Jackson, Mississippi 39201

WATER WELL DRILLERS LOG

7-14 1977 *James Jackson Stone*
 date well completed firm name county well located

LANDOWNER:	description of formations encountered	from	to
<i>Perlie Antelion</i>	<i>Topsoil</i>	0	4
(mailing address)	<i>Sand</i>	4	18
WELL LOCATION:	<i>Clay</i>	18	27
sec <i>26 T 2 N R 11 E</i>	<i>Coarse Sand</i>	27	56
<i>42</i> miles <i>E</i> of <i>Weggen</i>			
(distance) (direction) (nearest town)			
WELL PURPOSE: <i>HOME</i>			
(home, irrigation, municipal, industrial)			
WELL COMPLETION DATA:			
(1) diameter (inches) <i>2"</i>			
(2) total depth (feet) <i>3-6'</i>			
(3) static water level (feet) <i>17'</i> below top of ground.			
(4) casing <i>Plastic 57'</i>			
(material) (depth)			
(size) If telescope see back.			
(5) screen <i>5' 57'</i>			
(length) (depth to top)			
<i>2" Plastic</i>			
(size) (material)			
(6) pump <i>1 10</i>			
(HP) (yield gpm)			
<i>Elect</i>			
(type power)			
(7) electric log <i>No</i>			
(yes or no)			
(organization running log)			
(8) how well bottom plugged <i>Capped</i>			


RECEIVED
 AUG 5 1977

DRILLERS REMARKS:

MISS. BD. OF WATER COMMISSIONERS

If well telescopes please sketch and show depths.

GROUND LEVEL

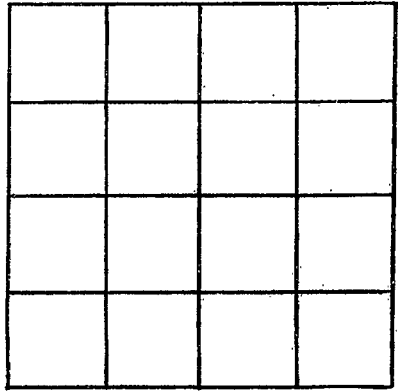

SECTION _____

Please indicate well location X.

ADDITIONAL INFORMATION

If more than one screen, show locations of each on sketch.