

STONE
C 2021
7-18-77

MISSISSIPPI
BOARD OF WATER COMMISSIONERS
416 North State Street
130 Jackson, Mississippi 39201

WATER WELL DRILLERS LOG

7-18 1977 Starnell Anderson Stone
date well completed firm name county well located


LANDOWNER:	description of formations encountered	from	to
<u>Robert Grantham</u>			
(mailing address)	<u>Red Clay</u>	<u>2</u>	<u>28</u>
WELL LOCATION:	<u>Fin Sand</u>	<u>28</u>	<u>38</u>
sec. <u>31</u> T. <u>2</u> N. R. <u>11</u> E. S. <u>5</u> W.	<u>Clay</u>	<u>35</u>	<u>60</u>
<u>1/2</u> miles S of <u>Wiggins</u>	<u>Coarse Sand</u>	<u>60</u>	<u>85</u>
(distance) (direction) (nearest town)			
WELL PURPOSE: <u>HOME</u> (home, irrigation, municipal, industrial)			
WELL COMPLETION DATA:			
(1) diameter (inches) <u>3 1/2</u>			
(2) total depth (feet) <u>85'</u>			
(3) static water level (feet) <u>5'</u> below top of ground			
(4) casing <u>Plastic</u> , <u>80'</u> (material) (depth)			
(size) If telescope see back.			
(5) screen <u>5'</u> <u>80'</u> (length) (depth to top)			
<u>2"</u> <u>Plastic</u> (size) (material)			
(6) pump <u>1</u> <u>9</u> (HP) (yield gpm)			
<u>Elect</u> (type power)			
(7) electric log <u>no</u> (yes or no)			
(organization running log)			
(8) how well bottom plugged <u>Capped</u>			
DRILLERS REMARKS:			

RECEIVED
AUG 5 1977

MISS. Bd. OF WATER COMMISSIONERS

If well telescopes please sketch and show depths.

GROUND LEVEL

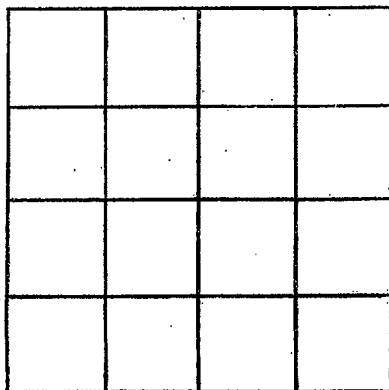

SECTION _____

Please indicate well location X.

ADDITIONAL INFORMATION

If more than one screen, show locations of each on sketch.