

Stone  
 C 2002  
 11/16/77

MISSISSIPPI  
 BOARD OF WATER COMMISSIONERS  
 416 North State Street  
 Jackson, Mississippi 39201

WATER WELL DRILLERS LOG

11-16 1977 Parnell Anderson Stone  
 date well completed firm name county well located


LANDOWNER:	description of formations encountered	from	to
Lee Prince  (mailing address)			
	Coarse Sand	2	5-8
<b>WELL LOCATION:</b>			
sec. <u>16</u> T <u>3</u> N R <u>11</u> E S W			
<u>2</u> miles <u>NE</u> of <u>Wologon</u> (distance) (direction) (nearest town)			
<b>WELL PURPOSE:</b> <u>HOME</u> (home, irrigation, municipal, industrial)			
<b>WELL COMPLETION DATA:</b>			
(1) diameter (inches) <u>2"</u>			
(2) total depth (feet) <u>5-8</u>			
(3) static water level (feet) <u>21'</u> below above top of ground.			
(4) casing <u>Plastic</u> , <u>53'</u> (material) (depth)			
_____ if telescope see back. (size)			
(5) screen <u>5'</u> , <u>53'</u> (length) (depth to top)			
<u>2"</u> , <u>Plastic</u> (size) (material)			
(6) pump <u>1</u> (HP) <u>9</u> (yield gpm)			
<u>Elect</u> (type power)			
(7) electric log <u>no</u> (yes or no)			
_____ (organization running log)			
(8) how well bottom plugged <u>Capped</u>			
DRILLERS REMARKS:			

RECEIVED  
 DEC 6 1977

MISS. BD. OF WATER COMMISSIONERS

If well telescopes please sketch and show depths.

GROUND LEVEL

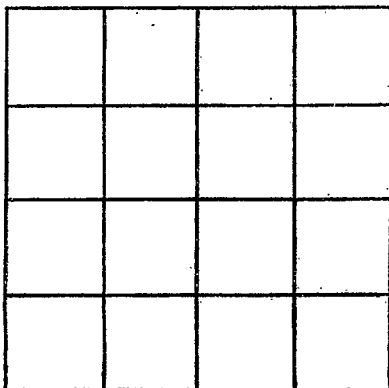

SECTION \_\_\_\_\_

Please indicate well location X.

ADDITIONAL INFORMATION

If more than one screen,  
show locations of each on sketch.