

Stone  
C 2003  
12/19/77

MISSISSIPPI  
BOARD OF WATER COMMISSIONERS  
416 North State Street  
Jackson, Mississippi 39201

WATER WELL DRILLERS LOG

12-19 19 77 SWITZER WELL COMPANY STONE  
date well completed firm name county well located

LANDOWNER: <u>EUGENE J. BRELAND</u>	description of formations encountered	from	to
<u>RT. 1 BOX 18</u>	CLAY	0	40
<u>Wiggins, MS. 39577</u> (mailing address)	SAND	40	130
WELL LOCATION:	CLAY	130	351
sec. <u>33</u> T. <u>2</u> N R. <u>11</u> E	SAND	351	376
<u>4</u> miles <u>SE</u> of <u>Wiggins</u>	CLAY	376	430
(distance) (direction) (nearest town)	SAND	430	440
WELL PURPOSE: <u>Home</u> (home, irrigation, municipal, industrial)	CLAY	440	540
WELL COMPLETION DATA:	SAND (40' COARSE)	540	600
(1) diameter (inches) <u>4" x 3"</u>	COARSE SAND & GRAVEL	600	634
(2) total depth (feet) <u>634 ft.</u>			
(3) static water level (feet) <u>115'</u> <sup>below</sup> top of ground.			
(4) casing <u>Galv. Pipe</u> , <u>6 1/4"</u> (material) (depth)			
<u>4 x 3</u> If telescope see back. (size)			
(5) screen <u>20'</u> , <u>6 1/4"</u> (length) (depth to top)			
<u>3"</u> , <u>STAINLESS WRAPPED</u> (size) (material)			
(6) pump <u>TO BE FURNISHED BY OWNER</u> (HP) (yield gpm)			
(type power)			
(7) electric log <u>NO</u> (yes or no)			
(organization running log)			
(8) how well bottom plugged <u>Ball Check Back Wash Valve</u>			
DRILLERS REMARKS:			

RECEIVED  
JAN 17 1978

MISS. BD. OF WATER COMM


If well telescopes please sketch and show depths.

GROUND LEVEL

318'  
4" GALV.  
PIPE

296'  
3"  
GALV.  
PIPE

10' 89A STAINLESS  
WRAPPED SCREEN  
10' 89A STAINLESS  
WRAPPED SCREEN  
3" BALL CHECK  
BACKWASH  
VALVE

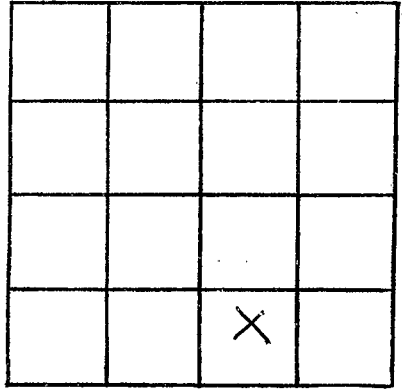

SECTION 33

Please indicate well location X.

ADDITIONAL INFORMATION

If more than one screen,  
show locations of each on sketch.