

STONE
2025 G
5-3-78

MISSISSIPPI
BOARD OF WATER COMMISSIONERS
416 North State Street
Jackson, Mississippi 39201

WATER WELL DRILLERS LOG

5-3 1978 *Samuel Anderson Stone*
date well completed firm name county well located


LANDOWNER:	description of formations encountered	from	to
<i>Clent Smith</i>	<i>Top Soil</i>	0	1
(mailing address)	<i>Rich Clay</i>	1	21
WELL LOCATION: sec. <i>17</i> T. <i>2</i> R. <i>11</i> E <i>1 1/2</i> miles <i>NE</i> of <i>Wiggins</i> (distance) (direction) (nearest town)	<i>Coarse Sand</i>	21	23
WELL PURPOSE: <i>HOME</i> (home, irrigation, municipal, industrial)			
WELL COMPLETION DATA:			
(1) diameter (inches) <i>2"</i>			
(2) total depth (feet) <i>63</i>			
(3) static water level (feet) <i>42</i> below above top of ground.			
(4) casing <i>Plastic 58'</i> (material) (depth)			
_____ if telescope see back. (size)			
(5) screen <i>5'</i> <i>58'</i> (length) (depth to top)			
<i>2"</i> <i>Plastic</i> (size) (material)			
(6) pump <i>1</i> <i>10</i> (HP) (yield gpm)			
<i>Elect</i> (type power)			
(7) electric log <i>no</i> (yes or no)			
_____ (organization running log)			
(8) how well bottom plugged <i>Capped</i>			
DRILLERS REMARKS:			

RECEIVED
JUN - 2 1978

MISS. BD. OF WATER COMMISSIONERS

If well telescopes please sketch and show depths.

GROUND LEVEL

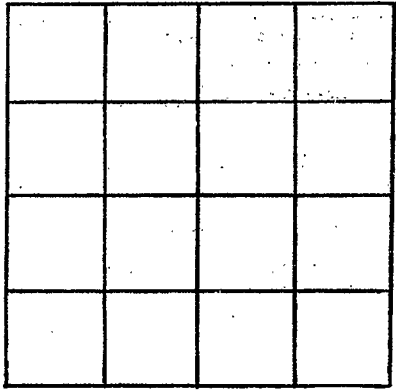

SECTION _____

Please indicate well location X.

ADDITIONAL INFORMATION

If more than one screen, show locations of each on sketch.