

STONE
C 2027
7-19-78

**MISSISSIPPI
BOARD OF WATER COMMISSIONERS**
416 North State Street
Jackson, Mississippi 39201

WATER WELL DRILLERS LOG

July 19 1978 Duncan Well Drilling Stone
 date well completed firm name county well located

LANDOWNER: <u>Roland Edwards</u> <u>P.O. Box 487</u> <u>Wiggins, Ms. 39577</u> (mailing address)	description of formations encountered	from	to
	<u>Red Clay</u>	<u>0</u>	<u>18</u>
	<u>Course Sand</u>	<u>18</u>	<u>115</u>

WELL LOCATION:
 sec 14 T 2 N R 11 E
6 miles NE of Wiggins
 (distance) (direction) (nearest town)


WELL PURPOSE: Home
 (home, irrigation, municipal, industrial)

WELL COMPLETION DATA:

- (1) diameter (inches) ~~4~~ 2"
- (2) total depth (feet) 115
- (3) static water level (feet) 22 below
 top of ground.
- (4) casing PVC, 105,
 (material) (depth)
 _____ if telescope see back.
 (size)
- (5) screen 10', 105
 (length) (depth to top)
2", PVC
 (size) (material)
- (6) pump 1 10
 (HP) (yield gpm)
electric
 (type power)
- (7) electric log _____
 (yes or no)

 (organization running log)
- (8) how well bottom plugged Sand
Shank

DRILLERS REMARKS:

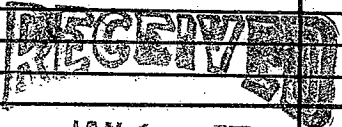


JAN 10 1978

MISSISSIPPI WATER COMMISSIONERS

If well telescopes please sketch and show depths.

GROUND LEVEL

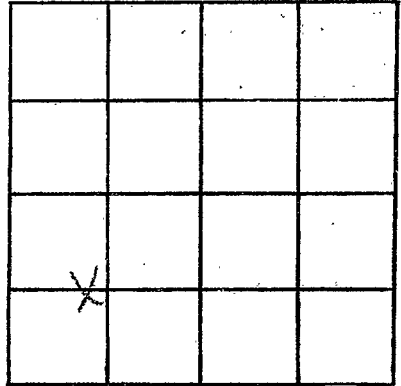

SECTION 14

Please indicate well location X.

ADDITIONAL INFORMATION

If more than one screen,
show locations of each on sketch.