


STONE
C 2031
9-12-78

MISSISSIPPI
BOARD OF WATER COMMISSIONERS
416 North State Street
Jackson, Mississippi 39201

WATER WELL DRILLERS LOG

9-12 1978 Pamell Anderson Stone
date well completed firm name county well located

LANDOWNER:	description of formations encountered	from	to
<u>Bill Cooley</u>	<u>Top Soil</u>	<u>0</u>	<u>5</u>
(mailing address)	<u>Course Sand</u>	<u>3</u>	<u>6 3/4</u>
WELL LOCATION:			
sec. <u>9</u> T <u>2</u> N R <u>11</u> E S W			
2 miles <u>NE</u> of <u>Wiggins</u> (distance) (direction) (nearest town)			
WELL PURPOSE: <u>HOME</u> (home, irrigation, municipal, industrial)			
WELL COMPLETION DATA:			
(1) diameter (inches) <u>2"</u>			
(2) total depth (feet) <u>63</u>			
(3) static water level (feet) <u>29</u> below top of ground.			
(4) casing <u>Plastic 5-8'</u> (material) (depth)			
_____ if telescope see back. (size)			
(5) screen <u>5'</u> , <u>5-8'</u> (length) (depth to top)			
<u>2"</u> , <u>Plastic</u> (size) (material)			
(6) pump <u>1</u> <u>11</u> (HP) (yield gpm)			
<u>Elect</u> (type power)			
(7) electric log <u>no</u> (yes or no)			
_____ (organization running log)			
(8) how well bottom plugged <u>Capped</u>			

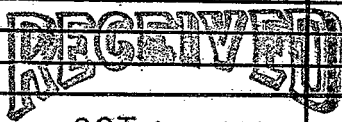


OCT 12 1978

DRILLERS REMARKS:

If well telescopes please sketch and show depths.

GROUND LEVEL

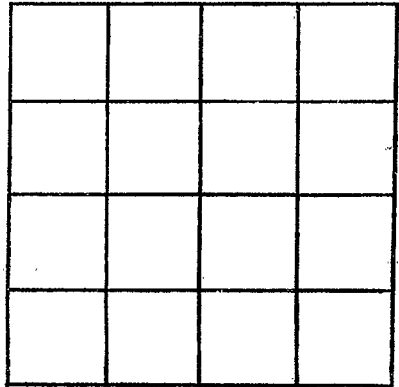

SECTION _____

Please indicate well location X.

ADDITIONAL INFORMATION

If more than one screen,
show locations of each on sketch.