

STONE
 2032 C
 11-8-78

MISSISSIPPI
 BOARD OF WATER COMMISSIONERS
 416 North State Street
 Jackson, Mississippi 39201

WATER WELL DRILLERS LOG

11-8 1978 *Parnell Woodman* *Stone*
 date well completed firm name county well located


LANDOWNER:	description of formations encountered	from	to
<i>Charles Whitney</i>			
(mailing address)	<i>course sand</i>	<i>3</i>	<i>25</i>
WELL LOCATION:	<i>clay</i>	<i>25</i>	<i>28</i>
sec <i>95</i> T <i>2</i> # <i>W</i> R <i>11 E</i> S <i>W</i>	<i>course sand</i>	<i>28</i>	<i>63</i>
<i>5</i> miles <i>E</i> of <i>Wiggins</i>			
(distance) (direction) (nearest town)			
WELL PURPOSE: <i>HOME</i>			
(home, irrigation, municipal, industrial)			
WELL COMPLETION DATA:			
(1) diameter (inches) <i>2"</i>			
(2) total depth (feet) <i>63'</i>			
(3) static water level (feet) <i>18'</i> below top of ground.			
(4) casing <i>Plastic</i> <i>58'</i>			
(material) (depth)			
(size) if telescope see back.			
(5) screen <i>5"</i> <i>58'</i>			
(length) (depth to top)			
<i>2"</i> <i>Plastic</i>			
(size) (material)			
(6) pump <i>1</i> <i>12</i>			
(HP) (yield gpm)			
<i>Elect</i>			
(type power)			
(7) electric log <i>no</i>			
(yes or no)			
(organization running log)			
(8) how well bottom plugged <i>Capped</i>			
DRILLERS REMARKS:			

RECEIVED
 DEC - 7 1978

MISS. BD. OF WATER COMMISSIONERS

If well telescopes please sketch and show depths.

GROUND LEVEL

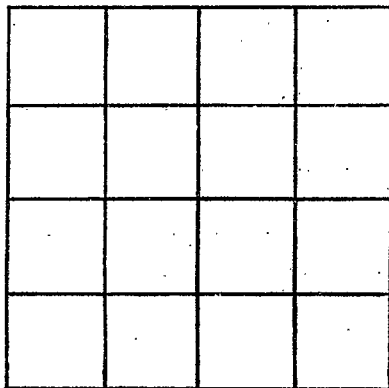

SECTION _____

Please indicate well location X.

ADDITIONAL INFORMATION

If more than one screen,
show locations of each on sketch.