

STONE
C 2033
11-15-78

**MISSISSIPPI
BOARD OF WATER COMMISSIONERS**
416 North State Street
Jackson, Mississippi 39201

WATER WELL DRILLERS LOG

11-15-78 date well completed 19 78 Pernell Pickens firm name Stone county well located

LANDOWNER:
Dr. John Ratiliff

(mailing address)

WELL LOCATION:
sec 8 T 2 N R 11 E
S W
1/2 miles E of Wiggins
(distance) (direction) (nearest town)

WELL PURPOSE: HOME
(home, irrigation, municipal, industrial)

WELL COMPLETION DATA:

(1) diameter (inches) 2"

(2) total depth (feet) 83'

(3) static water level (feet) 38' below top of ground.

(4) casing Plastic 80'
(material) (depth)

(size) if telescope see back.

(5) screen 5' 80'
(length) (depth to top)

2" Plastic
(size) (material)

(6) pump 1 13
(HP) (yield gpm)

Elect
(type power)

(7) electric log no
(yes or no)

(organization running log)

(8) how well bottom plugged Capped


description of formations encountered	from	to
<u>Top Soil</u>	<u>0</u>	<u>2</u>
<u>Red Clay</u>	<u>2</u>	<u>25</u>
<u>Fine Sand</u>	<u>25</u>	<u>72</u>
<u>Course Sand</u>	<u>72</u>	<u>83</u>

RECEIVED
ALL
DEC-7-1978
MISS. BD. OF WATER COMM.

DRILLERS REMARKS:

If well telescopes please sketch and show depths.

GROUND LEVEL

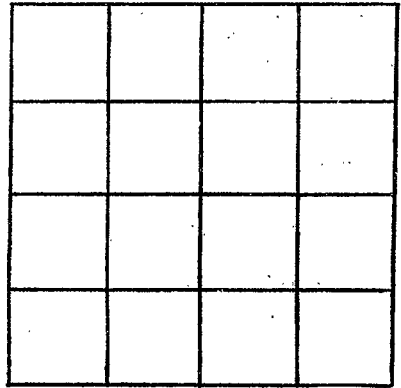

SECTION _____

Please indicate well location X.

ADDITIONAL INFORMATION

If more than one screen,
show locations of each on sketch.