

STONE
C 2034
11-22-78

**MISSISSIPPI
BOARD OF WATER COMMISSIONERS**
416 North State Street
Jackson, Mississippi 39201

WATER WELL DRILLERS LOG

11-22-78 Parnell Henderson Stone
 date well completed firm name county well located


LANDOWNER:	description of formations encountered	from	to
<u>John Belvey</u> (mailing address)	<u>Top Soil</u>	0	2
WELL LOCATION: sec. <u>31</u> T. <u>2</u> N. R. <u>11</u> E. S. <u>W</u>	<u>Clay</u>	2	15
? miles <u>S</u> of <u>Wiggins</u> (distance) (direction) (nearest town)	<u>7 In. Sand</u>	15	60
WELL PURPOSE: <u>HOME</u> (home, irrigation, municipal, industrial)	<u>Clay</u>	60	65
WELL COMPLETION DATA:	<u>Course Sand</u>	65	105
(1) diameter (inches) <u>2"</u>			
(2) total depth (feet) <u>105'</u>			
(3) static water level (feet) <u>48</u> below top of ground.			
(4) casing <u>P. Plastic 100'</u> (material) (depth)			
_____ (size) If telescope see back.			
(5) screen <u>5'</u> <u>100'</u> (length) (depth to top)			
<u>2"</u> <u>Plastic</u> (size) (material)			
(6) pump <u>1</u> <u>10</u> (HP) (yield gpm)			
<u>Elect</u> (type power)			
(7) electric log <u>No</u> (yes or no)			
_____ (organization running log)			
(8) how well bottom plugged <u>Capped</u>			
DRILLERS REMARKS:			

RECEIVED
DEC-7 1978

MISS. BD. OF WATER/COMM

If well telescopes please sketch and show depths.

GROUND LEVEL

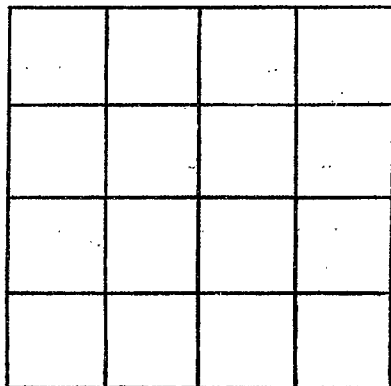

SECTION _____

Please indicate well location X.

ADDITIONAL INFORMATION

If more than one screen,
show locations of each on sketch.