

STONE
C 2035
12-01-78

**MISSISSIPPI
BOARD OF WATER COMMISSIONERS**
416 North State Street
Jackson, Mississippi 39201

WATER WELL DRILLERS LOG

12-1 1978 Pennell Anderson Stone
 date well completed firm name county well located


LANDOWNER:	description of formations encountered	from	to
<u>Norman Couart</u>			
(mailing address)	<u>Red Clay</u>	<u>2</u>	<u>25</u>
WELL LOCATION:	<u>Course Sand</u>	<u>25</u>	<u>64</u>
sec. <u>28</u> T. <u>2</u> N. <u>11</u> E. S. <u>W</u>			
<u>7</u> miles <u>E</u> of <u>Wiggins</u>			
(distance) (direction) of (nearest town)			
WELL PURPOSE: <u>HOME</u>			
(home, irrigation, municipal, industrial)			
WELL COMPLETION DATA:			
(1) diameter (inches) <u>2"</u>			
(2) total depth (feet) <u>64'</u>			
(3) static water level (feet) <u>18</u> below top of ground.			
(4) casing <u>Plastic</u> , <u>59'</u>			
(material) (depth)			
(size) If telescope see-back.			
(5) screen <u>5'</u> , <u>5-9'</u>			
(length) (depth to top)			
<u>2"</u> , <u>Plastic</u>			
(size) (material)			
(6) pump <u>1</u> , <u>12</u>			
(HP) (yield gpm)			
<u>Electric</u>			
(type power)			
(7) electric log <u>no</u>			
(yes or no)			
(organization running log)			
(8) how well bottom plugged <u>Capped</u>			
DRILLERS REMARKS:			

RECEIVED
JAN 8 1978

MISS. BD. OF WATER COMM

If well telescopes please sketch and show depths.

GROUND LEVEL

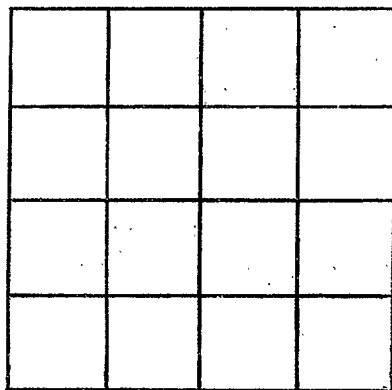

SECTION _____

Please indicate well location X.

ADDITIONAL INFORMATION

If more than one screen,
show locations of each on sketch.