

Stone
C. 2034
3-29-79

MISSISSIPPI
BOARD OF WATER COMMISSIONERS
416 North State Street
Jackson, Mississippi 39201

WATER WELL DRILLERS LOG

3-29 1979 Carroll Anderson Stone
date well completed firm name county well located

LANDOWNER:
Myrtle Gene Bond
Gene
(mailing address)

description of formations encountered	from	to
<u>Top Soil</u>	<u>0</u>	<u>2</u>
<u>Shandy Clay</u>	<u>2</u>	<u>35</u>
<u>Course Sand</u>	<u>35</u>	<u>85</u>

WELL LOCATION:
sec. 17 T. 2 N. R. 11 E.
S. W.
2 miles E of Wyers
(distance) (direction) (nearest town)

WELL PURPOSE: DOMESTIC
(home, irrigation, municipal, industrial)

- WELL COMPLETION DATA:
- diameter (inches) 2"
 - total depth (feet) 85'
 - static water level (feet) 61' below top of ground.
 - casing Plastic, 80'
(material) (depth)
(size) if telescope see back.
 - screen 5", 80'
(length) (depth to top)
2", Plastic
(size) (material)
 - pump 1, 12
(HP) (yield gpm)
Electric
(type power)
 - electric log No
(yes or no)
(organization running log)
 - how well bottom plugged Capped

DRILLERS REMARKS:


Miss. Board of Water Comm.

APR 2 - 1979

RECEIVED

If well telescopes please sketch and show depths.

GROUND LEVEL

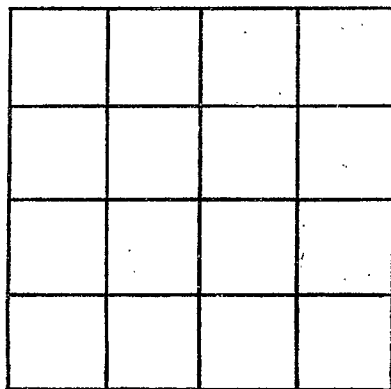

SECTION _____

Please indicate well location X.

ADDITIONAL INFORMATION

If more than one screen,
show locations of each on sketch.