

Stone  
C 2037  
5-8-79

MISSISSIPPI  
BOARD OF WATER COMMISSIONERS  
416 North State Street  
Jackson, Mississippi 39201

WATER WELL DRILLERS LOG

5-8 1979 79 Farnell Anderson Stone  
date well completed firm name county well located

LANDOWNER:	description of formations encountered	from	to
Robert Newton Jr.	Top Soil	0	2
(mailing address)	Clay	1	74
WELL LOCATION:	Flint Sand	74	108
sec. <u>8</u> T. <u>2</u> N. R. <u>11</u> E. S. <u>1</u> W.	Coarse Sand	108	122
<u>1 1/2</u> miles <u>N</u> of <u>Wegon</u>			
(distance) (direction) (nearest town)			
WELL PURPOSE: <u>HOME</u> (home, irrigation, municipal, industrial)			
WELL COMPLETION DATA:			
(1) diameter (inches) <u>2"</u>			
(2) total depth (feet) <u>121'</u>			
(3) static water level (feet) <u>42</u> below top of ground.			
(4) casing <u>Plastic, 1 1/2"</u> (material) (depth)			
(size) if telescope see back.			
(5) screen <u>5"</u> , <u>116'</u> (length) (depth to top)			
<u>2"</u> , <u>Plastic</u> (size) (material)			
(6) pump <u>1</u> <u>11</u> (HP) (yield gpm)			
<u>Elect</u> (type power)			
(7) electric log <u>no</u> (yes or no)			
(organization running log)			
(8) how well bottom plugged <u>Capped</u>			
DRILLERS REMARKS:			


Miss. Board of Water Comm.

JUN - 8 1979

RECEIVED

If well telescopes please sketch and show depths.

GROUND LEVEL

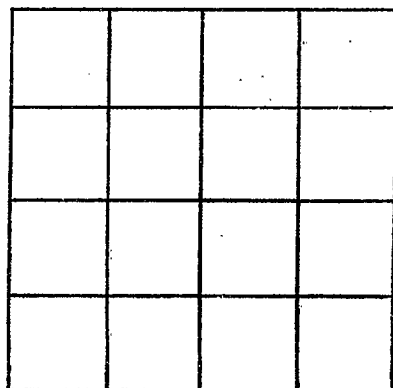

SECTION \_\_\_\_\_

Please indicate well location X.

ADDITIONAL INFORMATION

If more than one screen,  
show locations of each on sketch.