

Stone  
 C 2040  
 5-1-79

MISSISSIPPI  
 BOARD OF WATER COMMISSIONERS  
 416 North State Street  
 Jackson, Mississippi 39201

WATER WELL DRILLERS LOG

5-1 1979  
 date well completed

79 Farnell Anderson Stone  
 firm name

county well located

LANDOWNER:

James Shores

description of formations encountered

Top Soil

from 0 to 2

(mailing address)

Course Sand

2 43

WELL LOCATION:

sec 4 T 2 N R 11 E S W  
 5 miles NE of Wiggins  
 (distance) (direction) (nearest town)

WELL PURPOSE: HOME  
 (home, irrigation, municipal, industrial)

WELL COMPLETION DATA:

- (1) diameter (inches) 2"
- (2) total depth (feet) 43'
- (3) static water level (feet) 7' below top of ground.
- (4) casing Plastic, 38' (material) (depth)
- (size) If telescope see back.
- (5) screen 5" 38' (length) (depth to top)  
 2" Plastic (size) (material)
- (6) pump 1 (HP) 12 (yield gpm)  
 Collect (type power)
- (7) electric log No (yes or no)

(organization running log)

(8) how well bottom plugged  
 Cement

Miss. Board of Water Comm.


DRILLERS REMARKS:

JUN - 8 1979

RECEIVED

If well telescopes please sketch and show depths.

GROUND LEVEL

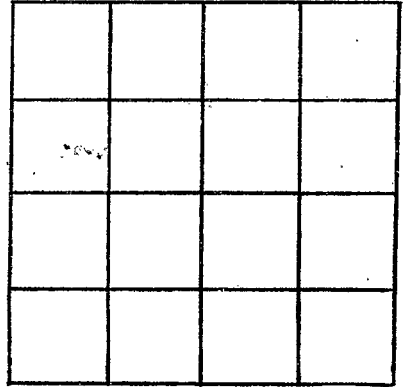

SECTION \_\_\_\_\_

Please indicate well location X.

ADDITIONAL INFORMATION

If more than one screen,  
show locations of each on sketch.