

STONE
 2041
 7-12-79

MISSISSIPPI
 BOARD OF WATER COMMISSIONERS
 416 North State Street
 Jackson, Mississippi 39201

WATER WELL DRILLERS LOG

7-12-1979 Parsons Petroleum Stone
 date well completed firm name county well located

LANDOWNER:
John Julianovich
 (mailing address)
 WELL LOCATION:
 sec. 21 T. 2 N R. 11 E
1 1/2 miles W of Wiggins
 (distance) (direction) (nearest town)

description of formations encountered	from	to
<u>Top Soil</u>	<u>0</u>	<u>3</u>
<u>Red Clay</u>	<u>3</u>	<u>28</u>
<u>Course Sand</u>	<u>28</u>	<u>64</u>

WELL PURPOSE: HOME
 (home, irrigation, municipal, industrial)

WELL COMPLETION DATA:
 (1) diameter (inches) 2"
 (2) total depth (feet) 64'
 (3) static water level (feet) 23 below above top of ground.
 (4) casing Plastic 5-9'
 (material) (depth)
 (size) if telescope see back.
 (5) screen 5' 5-9'
 (length) (depth to top)
2" Plastic
 (size) (material)
 (6) pump 1 10
 (HP) (yield gpm)
Elect
 (type power)
 (7) electric log no
 (yes or no)
 (organization running log)
 (8) how well bottom plugged Capred

Miss. Board of Water Comm.


DRILLERS REMARKS:

AUG 10 1979

RECEIVED

If well telescopes please sketch and show depths.

GROUND LEVEL

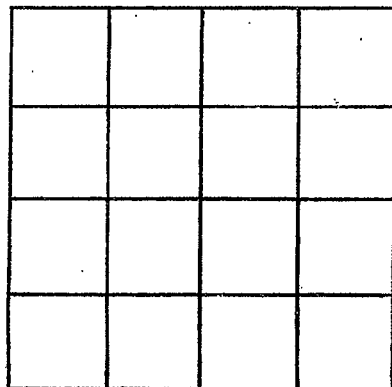

SECTION _____

Please indicate well location X.

ADDITIONAL INFORMATION

If more than one screen,
show locations of each on sketch.