

STONE
C 2042
7-13-79

MISSISSIPPI
BOARD OF WATER COMMISSIONERS
416 North State Street
Jackson, Mississippi 39201

WATER WELL DRILLERS LOG

7-13 date well completed 1979 Borne Well Drillers firm name Stone county well located

LANDOWNER:	description of formations encountered	from	to
<u>C. J. Colvart</u>	<u>Top Soil</u>	<u>0</u>	<u>2</u>
(mailing address)	<u>Red Clay</u>	<u>2</u>	<u>15</u>
WELL LOCATION:	<u>Fine Sand</u>	<u>15</u>	<u>25</u>
sec <u>21</u> T <u>2</u> N R <u>11</u> E S W <u>1 1/2</u> miles W of <u>Wiggins</u> (distance) (direction) (nearest town)	<u>Clay</u>	<u>25</u>	<u>32</u>
WELL PURPOSE: <u>HOME</u> (home, irrigation, municipal, industrial)	<u>Coarse Sand</u>	<u>32</u>	<u>85</u>
WELL COMPLETION DATA:			
(1) diameter (inches) <u>2"</u>			
(2) total depth (feet) <u>85'</u>			
(3) static water level (feet) <u>30</u> below above top of ground.			
(4) casing <u>Plastic</u> , <u>80'</u> (material) (depth)			
_____ if telescope see back. (size)			
(5) screen <u>5'</u> , <u>80'</u> (length) (depth to top)			
<u>2"</u> , <u>Plastic</u> (size) (material)			
(6) pump <u>1</u> , <u>12</u> (HP) (yield gpm)			
<u>Elect</u> (type power)			
(7) electric log <u>no</u> (yes or no)			
_____ (organization running log)			
(8) how well bottom plugged <u>Cap</u>			
DRILLERS REMARKS:			


Miss. Board of Water Comm.

AUG 10 1979

RECEIVED

If well telescopes please sketch and show depths.

GROUND LEVEL

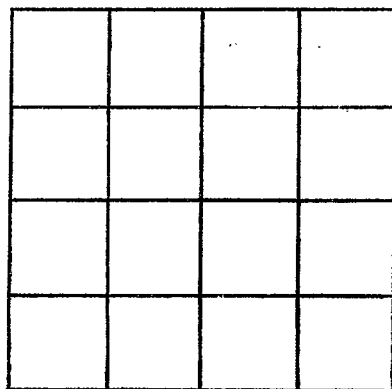

SECTION _____

Please indicate well location X.

ADDITIONAL INFORMATION

If more than one screen,
show locations of each on sketch.