

Stone  
C 2043  
Dec. 3, 1979

MISSISSIPPI  
BOARD OF WATER COMMISSIONERS  
416 North State Street  
Jackson, Mississippi 39201

WATER WELL DRILLERS LOG

18-3 1979 Purnell Anderson Stone  
date well completed firm name county well located


LANDOWNER:	description of formations encountered	from	to
Tommy Dale	Top Soil	0	3
(mailing address)	Sandy Clay	3	25
WELL LOCATION:	Fine Sand	25	65
sec. 27 T. 2 R. 11 E S W	Clay	65	69
2 1/2 miles E of Wiggli	Course Sand	69	105
(distance) (direction) (nearest town)			
WELL PURPOSE: HOME (home, irrigation, municipal, industrial)			
WELL COMPLETION DATA:			
(1) diameter (inches) 2"			
(2) total depth (feet) 105'			
(3) static water level (feet) 42' below top of ground.			
(4) casing Plastic, 100' (material) (depth)			
(size) if telescope see back.			
(5) screen 5', 100' (length) (depth to top)			
2" Plastic (size) (material)			
(6) pump 3/4 8 (HP) (yield gpm)			
Elect (type power)			
(7) electric log no (yes or no)			
(organization running log)			
(8) how well bottom plugged Capped			
DRILLERS REMARKS:			

DEPT. OF NATURAL RESOURCES  
BUREAU OF LAND & WATER RESOURCES

JAN 18 1980  
RECEIVED

If well telescopes please sketch and show depths.

GROUND LEVEL

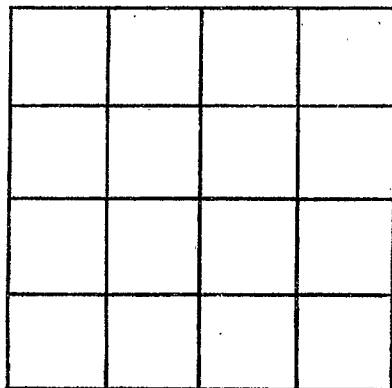

SECTION \_\_\_\_\_

Please indicate well location X.

ADDITIONAL INFORMATION

If more than one screen,  
show locations of each on sketch.