

Stone
C 2044
5-13-80

MISSISSIPPI
BOARD OF WATER COMMISSIONERS
416 North State Street
Jackson, Mississippi 39201

WATER WELL DRILLERS LOG

4-18 1980 Parrell Wilson Stone
date well completed firm name county well located

LANDOWNER:	description of formations encountered	from	to
<u>Keith Helger</u>	<u>Top Soil</u>	0	2
(mailing address)	<u>Red Clay</u>	2	24
WELL LOCATION:	<u>Thin Sand</u>	24	25
sec. <u>33</u> T <u>2</u> N R <u>11</u> E S W. <u>3</u> miles <u>SE</u> of <u>Wiggins</u> (distance) (direction) (nearest town)	<u>Coarse Sand</u>	25	83
WELL PURPOSE: <u>HOME</u> (home, irrigation, municipal, industrial)			
WELL COMPLETION DATA:			
(1) diameter (inches) <u>2"</u>			
(2) total depth (feet) <u>83'</u>			
(3) static water level (feet) <u>60"</u> below top of ground.			
(4) casing <u>Plastic</u> , <u>78'</u> (material) (depth)			
_____ If telescope see back. (size)			
(5) screen <u>5"</u> , <u>78'</u> (length) (depth to top)			
<u>3"</u> , <u>Plastic</u> (size) (material)			
(6) pump <u>1</u> , <u>8</u> (HP) (yield gpm)			
<u>Elect</u> (type power)			
(7) electric log <u>no</u> (yes or no)			
_____ (organization running log)			
(8) how well bottom plugged <u>Capped</u>			
DRILLERS REMARKS:			


DEPT. OF NATURAL RESOURCES
BUREAU OF LAND & WATER RESOURCES

MAY 12 1980

RECEIVED

If well telescopes please sketch and show depths.

GROUND LEVEL

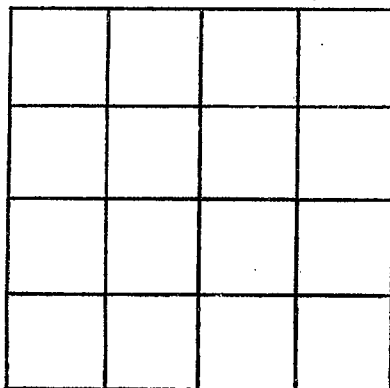

SECTION _____

Please indicate well location X.

ADDITIONAL INFORMATION

If more than one screen,
show locations of each on sketch.