

SPANK

MISSISSIPPI
 BOARD OF WATER COMMISSIONERS
 416 North State Street
 Jackson, Mississippi 39201

WATER WELL DRILLERS LOG

C 2045
 6-13-80
 6-13

1980 Arnold Anderson Steno
 date well completed firm name county well located

LANDOWNER:	description of formations encountered	from	to
<u>Fred Chisler</u>	<u>Top Soil</u>	<u>0</u>	<u>2</u>
(mailing address)	<u>Flint Sand</u>	<u>2</u>	<u>108</u>
WELL LOCATION:	<u>Coarse Sand</u>	<u>108</u>	<u>122</u>
sec <u>25</u> T. <u>2</u> S. R. <u>11</u> W.			
<u>5 1/2</u> miles of <u>W. N. W.</u> of <u>W. N. W.</u>			
(distance) (direction) (nearest town)			
WELL PURPOSE: <u>HOME</u> (home, irrigation, municipal, industrial)			
WELL COMPLETION DATA:			
(1) diameter (inches) <u>2"</u>			
(2) total depth (feet) <u>122'</u>			
(3) static water level (feet) <u>20'</u> below top of ground.			
(4) casing <u>Plastic</u> , <u>122'</u> (material) (depth)			
(size) If telescope see back.			
(5) screen <u>5'</u> , <u>122'</u> (length) (depth to top)			
<u>2"</u> , <u>Plastic</u> (size) (material)			
(6) pump <u>1</u> , <u>12</u> (HP) (yield gpm)			
<u>Elect</u> (type power)			
(7) electric log <u>no</u> (yes or no)			
(organization running log)			
(8) how well bottom plugged <u>Capped</u>			
DRILLERS REMARKS:			


DEPT. OF NATURAL RESOURCES
 BUREAU OF LAND & WATER RESOURCES

JUL 18 1980

RECEIVED

If well telescopes please sketch and show depths.

GROUND LEVEL

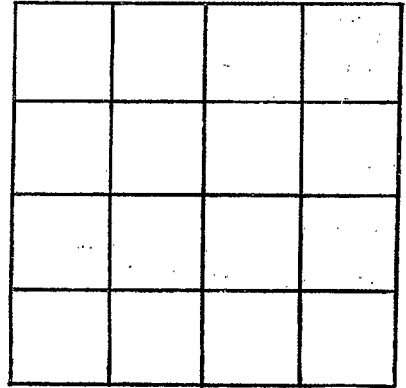

SECTION _____

Please indicate well location X.

ADDITIONAL INFORMATION

If more than one screen,
show locations of each on sketch.