

STONE
 C. Stone
 9-23-80

MISSISSIPPI
 BOARD OF WATER COMMISSIONERS
 416 North State Street
 Jackson, Mississippi 39201

WATER WELL DRILLERS LOG

9-23-80 19 Parnell Anderson Stone
 date well completed firm name county well located

LANDOWNER: Joe Shady
RT.
Meganne, Ms
 (mailing address)

WELL LOCATION:
 sec 34 T 24 R NE
S W
4 miles E of Wiggins
 (distance) (direction) (nearest town)

WELL PURPOSE: home
 (home, irrigation, municipal, industrial)

- WELL COMPLETION DATA:
- (1) diameter (inches) 2"
 - (2) total depth (feet) 62"
 - (3) static water level (feet) 39 below top of ground.
 - (4) casing Plastic 40'
 (material) (depth)
 - _____ if telescope see back.
 (size)
 - (5) screen 5'
 (length) (depth to top)
 - _____ (size) _____ (material)
 - (6) pump 1 10
 (HP) (yield gpm)
 - Electricity
 (type power)
 - (7) electric log NO
 (yes or no)
 - _____ (organization running log)
 - (8) how well bottom plugged Capped

description of formations encountered	from	to
TOP. Soil	0	3
SSWD	3	18
Clay	18	38
Fine Sand	38	46
Coarse sand	46	62

DEPT. OF NATURAL RESOURCES
 BUREAU OF LAND & WATER RESOURCES


OCT 14 1980

RECEIVED

DRILLERS REMARKS:

If well telescopes please sketch and show depths.

GROUND LEVEL

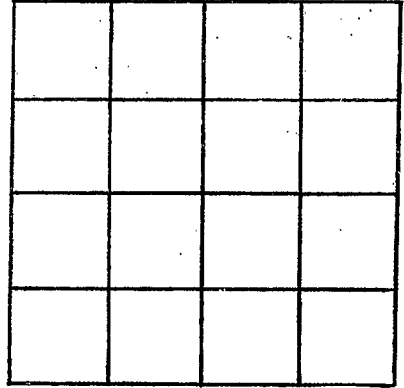

SECTION _____

Please indicate well location X.

ADDITIONAL INFORMATION

If more than one screen,
show locations of each on sketch.