

STONE
C 2057

MISSISSIPPI
BOARD OF WATER COMMISSIONERS
416 North State Street
Jackson, Mississippi 39201

WATER WELL DRILLERS LOG

10-21-80

10-21-

1980 Farness Anderson

Stone

date well completed

firm name

county well located

LANDOWNER: Daniel Haston

description of formations encountered

from

to

At 1
Wiggins
(mailing address)

Top Soil	0	2
Clay	2	19
Sand	19	28
Clay	28	40
Coarse Sand	40	56

WELL LOCATION:

sec 20 T 2 S R 11 W
1 miles E of Wiggins
(distance) (direction) (nearest town)

WELL PURPOSE: Stone
(home, irrigation, municipal, industrial)

WELL COMPLETION DATA:

- (1) diameter (inches) 2"
- (2) total depth (feet) 56'
- (3) static water level (feet) 38' below top of ground.
- (4) casing Plastic, 51'
(material) (depth)
2" (size) if telescope see back.
- (5) screen 2" 5'
(length) (depth to top)
2" Plastic
(size) (material)
- (6) pump 1 10
(HP) (yield gpm)
Electric
(type power)
- (7) electric log NO
(yes or no)

(organization running log)

(8) how well bottom plugged Copper

DEPT. OF NATURAL RESOURCES
BUREAU OF LAND & WATER RESOURCES


JAN 12 1981

DRILLERS REMARKS:

RECEIVED

If well telescopes please sketch and show depths.

GROUND LEVEL

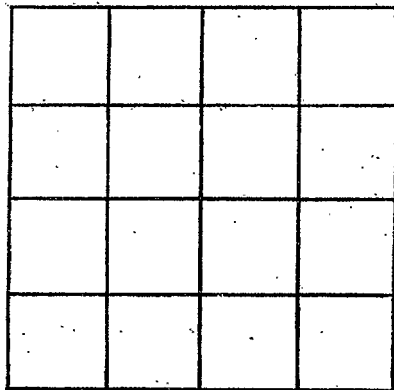

SECTION _____

Please indicate well location X.

ADDITIONAL INFORMATION

If more than one screen,
show locations of each on sketch.