

MISSISSIPPI DEPARTMENT OF NATURAL RESOURCES

Bureau of Land and Water Resources

Southport Mall

P.O. Box 10631

Jackson, Mississippi 39209

WATER WELL DRILLERS LOG

STONE
C 2048
2/27/81
Feb 127

1981 Farnell Anderson Stone
firm name county well located

date well completed

firm name

county well located

LANDOWNER: David Taylor
Rt 3
Wiggins, Ms 3957
(mailing address)

description of formations encountered	from	to
Top soil	0	3
clay	3	18
fine sand	18	24
clay	34	66
sand	66	74

WELL LOCATION:

sec. 12 T. 2 N. R. 11 E.
8 miles E of Wiggins
(distance) (direction) (nearest town)

WELL PURPOSE: home
(home, irrigation, municipal, industrial)

WELL COMPLETION DATA:

- (1) diameter (inches) 2"
- (2) total depth (feet) 74'
- (3) static water level (feet) 45' below top of ground.
- (4) casing P.V.C. 69'
(material) (depth)
- _____ if telescope see back.
(size)
- (5) screen 5' 69'
(length) (depth to top)
- 2" P.V.C.
(size) (material)
- (6) pump 1 12
(HP) (yield gpm)
- Electric
(type power)
- (7) electric log NO
(yes or no)
- _____ (organization running log)
- (8) how well bottom plugged Yes

MISSISSIPPI DEPARTMENT OF NATURAL RESOURCES
BUREAU OF LAND & WATER RESOURCES


MAY 18 1981

RECEIVED

DRILLERS REMARKS:

If well telescopes please sketch and show depths.

GROUND LEVEL

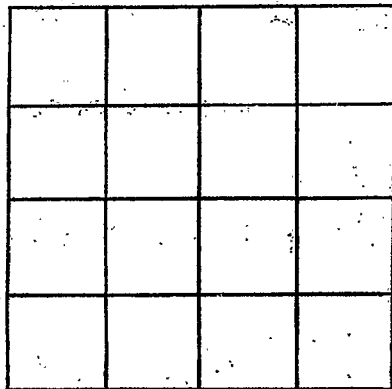

SECTION _____

Please indicate well location X.

ADDITIONAL INFORMATION

If more than one screen,
show locations of each on sketch.