

MISSISSIPPI DEPARTMENT OF NATURAL RESOURCES

Bureau of Land and Water Resources

Southport Mall

P.O. Box 10631

Jackson, Mississippi 39209

WATER WELL DRILLERS LOG

Stone
C2049
3/6/81

March 6 1981 date well completed
Parnell Anderson Stone firm name
Stone county well located

LANDOWNER: David Smith
Pt 2 Box 16
Wiggins Ms
(mailing address)

description of formations encountered	from	to
Top Soil	0	3
Clay	3	24
Fine Sand	24	56
Coarse Sand	56	84

WELL LOCATION: 11 W
sec 30 T 2 N R 14 E
3 miles S of Wiggins
(distance) (direction) (nearest town)

WELL PURPOSE: Home
(home, irrigation, municipal, industrial)


- WELL COMPLETION DATA:
- (1) diameter (inches) 2"
 - (2) total depth (feet) 84'
 - (3) static water level (feet) 50' below top of ground.
 - (4) casing PVC, 79' (material) (depth)
 - (size) If telescope see back.
 - (5) screen 5' length, 79' depth to top
 - 2" (size), PVC (material)
 - (6) pump 1 (HP), 11 (yield gpm)
 - Electric (type power)
 - (7) electric log NO (yes or no)
 - (organization running log)
 - (8) how well bottom plugged Yes

DRILLERS REMARKS:

DEPT. OF NATURAL RESOURCES
BUREAU OF LAND & WATER RESOURCES
MAY 18 1981
RECEIVED

If well telescopes please sketch and show depths.

GROUND LEVEL

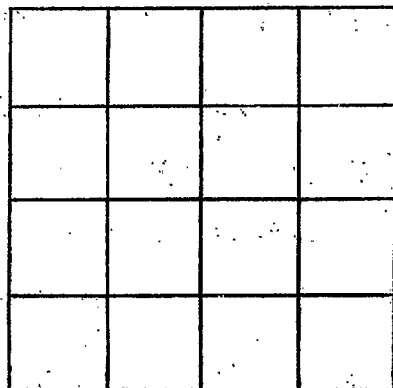

SECTION _____

Please indicate well location X.

ADDITIONAL INFORMATION

If more than one screen,
show locations of each on sketch.