

MISSISSIPPI DEPARTMENT OF NATURAL RESOURCES

Bureau of Land and Water Resources

Southport Mall

P.O. Box 10631

Jackson, Mississippi 39209

WATER WELL DRILLERS LOG

State  
 C 2050  
 3/6/81  
 March 6

date well completed

firm name

county well located

1981 Parrell Anderson Stone

LANDOWNER: Therman Conbit

description of formations encountered

from

to

Rt 1  
Wiggins, Ms 39577  
 (mailing address)

<u>Top Soil</u>	<u>0</u>	<u>3</u>
<u>Sandy clay</u>	<u>3</u>	<u>28</u>
<u>Sand</u>	<u>28</u>	<u>46</u>
<u>Clay</u>	<u>46</u>	<u>80</u>
<u>Sand</u>	<u>80</u>	<u>105</u>

WELL LOCATION:

sec. 29 T. 2 N. R. 11 W. E. W.  
2 miles SE of Wiggins  
 (distance) (direction) (nearest town)

WELL PURPOSE: Home  
 (home, irrigation, municipal, industrial)

WELL COMPLETION DATA:

- (1) diameter (inches) 2"
- (2) total depth (feet) 69' 105'
- (3) static water level (feet) 50 below above top of ground.
- (4) casing PVC, 100'  
 (material) (depth)  
 (size) If telescope see back.
- (5) screen 5', 100'  
 (length) (depth to top)  
2", PVC  
 (size) (material)
- (6) pump 1, 12  
 (HP) (yield gpm)  
Electric  
 (type power)
- (7) electric log NO  
 (yes or no)

(organization running log)

(8) how well bottom plugged Yes


DRILLERS REMARKS:

DEPT. OF NATURAL RESOURCES  
 BUREAU OF LAND & WATER RESOURCES

MAY 18 1981  
 RECEIVED

If well telescopes please sketch and show depths.

GROUND LEVEL

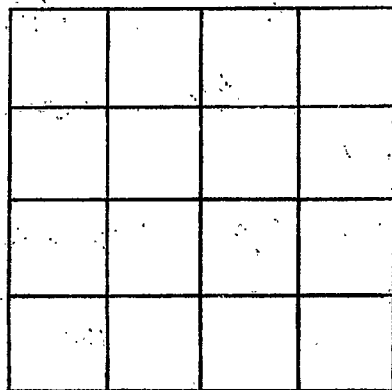

SECTION \_\_\_\_\_

Please indicate well location X.

ADDITIONAL INFORMATION

If more than one screen,  
show locations of each on sketch.