

MISSISSIPPI DEPARTMENT OF NATURAL RESOURCES

Bureau of Land and Water Resources

Southport Mall

P.O. Box 10631

Jackson, Mississippi 39209

WATER WELL DRILLERS LOG

STONE
C 2051
3/19/81

March 19 1981 Barnell Anderson Stone
date well completed firm name county well located

LANDOWNER: Frank Gody
Pt 1
Wiggins, MS
(mailing address)

description of formations encountered	from	to
<u>Top Soil</u>	<u>0</u>	<u>3</u>
<u>Sandy clay</u>	<u>3</u>	<u>19</u>
<u>clay</u>	<u>19</u>	<u>38</u>
<u>Fine Sand</u>	<u>38</u>	<u>42</u>
<u>Coarse Sand</u>	<u>42</u>	<u>65</u>

WELL LOCATION:
sec 34 T-2 N R-11 E
4 miles E of Wiggins
(distance) (direction) (nearest town)

WELL PURPOSE: home
(home, irrigation, municipal, industrial)

WELL COMPLETION DATA:

(1) diameter (inches) 2"

(2) total depth (feet) 65'

(3) static water level (feet) 28' below above top of ground.

(4) casing Pvc, 60'
(material) (depth)

 if telescope see back.
(size)

(5) screen 5', 60'
(length) (depth to top)

3" P.V.C
(size) (material)

(6) pump 1, 10
(HP) (yield gpm)

Electric
(type power)

(7) electric log No
(yes or no)

(organization running log)

(8) how well bottom plugged Yes


DRILLERS REMARKS:

DEPT. OF NATURAL RESOURCES
BUREAU OF LAND & WATER RESOURCES

MAY 18 1981
RECEIVED

If well telescopes please sketch and show depths.

GROUND LEVEL

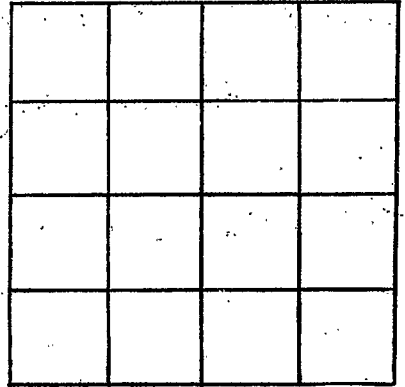

SECTION _____

Please indicate well location X.

ADDITIONAL INFORMATION

If more than one screen,
show locations of each on sketch.