

MISSISSIPPI DEPARTMENT OF NATURAL RESOURCES

Bureau of Land and Water Resources

Southport Mall

P.O. Box 10631

Jackson, Mississippi 39209

WATER WELL DRILLERS LOG

STONE
C-2052
4/1/81

April 1 1981 Larnee Anderson Stone  
 date well completed firm name county well located

LANDOWNER: Hugh Cortart  
2274th St  
Wiggins, MS 39577  
 (mailing address)

description of fomations encountered	from	to
Top soil	0	3
Red sand	3	28
Clay	28	65
Fine sand	65	88
Coarse sand	88	105

WELL LOCATION:  
 sec 29 T 2 N R 11 E  
2 1/2 miles E of Wiggins  
 (distance) (direction) (nearest town)


WELL PURPOSE: home  
 (home, irrigation, municipal, industrial)

- WELL COMPLETION DATA:
- (1) diameter (inches) 2"
  - (2) total depth (feet) 105
  - (3) static water level (feet) 45' below top of ground.
  - (4) casing Pvc, 100'  
 (material) (depth)  
 (size) if telescope see back.
  - (5) screen 5', 100'  
 (length) (depth to top)  
2", Pvc  
 (size) (material)
  - (6) pump 1 (HP) 12 (yield gpm)  
Electric  
 (type power)
  - (7) electric log NO  
 (yes or no)

(organization running log)


(8) how well bottom plugged Capped

DRILLERS REMARKS:

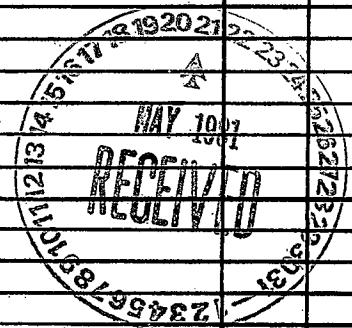

If well telescopes please sketch and show depths.

GROUND LEVEL

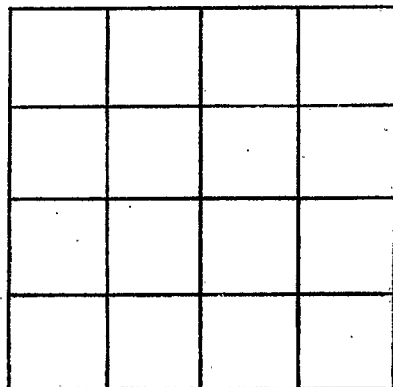

SECTION \_\_\_\_\_

Please indicate well location X.

ADDITIONAL INFORMATION

If more than one screen,  
show locations of each on sketch.