

MISSISSIPPI DEPARTMENT OF NATURAL RESOURCES

Bureau of Land and Water Resources

Southport Mall

P.O. Box 10631

Jackson, Mississippi 39209

WATER WELL DRILLERS LOG

STONE
C 2053
4/17/81

April 17 1981 81 Farnell Anderson Stone Stone
date well completed firm name county well located


LANDOWNER: Hilton Murry
Pat 2
Wiggins MS
(mailing address)

description of formations encountered	from	to
<u>Top soil</u>	<u>0</u>	<u>3</u>
<u>Red sand</u>	<u>3</u>	<u>28</u>
<u>Clay</u>	<u>28</u>	<u>34</u>
<u>Fine sand</u>	<u>34</u>	<u>60</u>
<u>Clay</u>	<u>60</u>	<u>82</u>
<u>Coarse sand</u>	<u>82</u>	<u>105</u>

WELL LOCATION:
sec 31 T 2 N R 11 E
4 miles S of Wiggins
(distance) (direction) (nearest town)

WELL PURPOSE: Home
(home, irrigation, municipal, industrial)

- WELL COMPLETION DATA:
- (1) diameter (inches) 2"
 - (2) total depth (feet) 105'
 - (3) static water level (feet) 45 below above top of ground.
 - (4) casing PVC 100'
(material) (depth)
If telescope see back.
(size)
 - (5) screen 5' 100'
(length) (depth to top)
2" PVC
(size) (material)
 - (6) pump 1 12
(HP) (yield gpm)
Electric
(type power)
 - (7) electric log No
(yes or no)

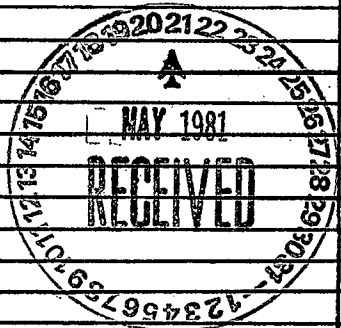


(organization running log)

(8) how well bottom plugged Copped

DRILLERS REMARKS:

If well telescopes please
sketch and show depths.

GROUND LEVEL

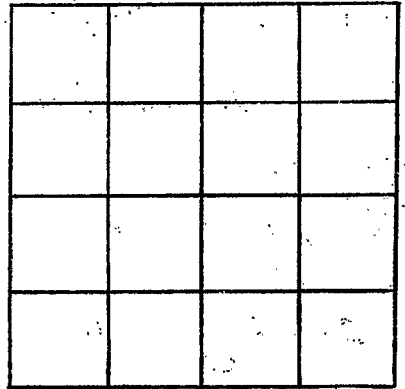

SECTION _____

Please indicate well location X.

ADDITIONAL INFORMATION

If more than one screen,
show locations of each on sketch.