

Stone
 C2055
 6-2-81

MISSISSIPPI
 BOARD OF WATER COMMISSIONERS
 416 North State Street
 Jackson, Mississippi 39201

WATER WELL DRILLERS LOG
 BRADEN PUMP AND WELL SERVICE, INC.

6-2-81
 date well completed

ROUTE 1, BOX 489
 SAUCIER, MS 39574

Stone
 county well located

LANDOWNER:
 Ethel Williams
 Rt. 1, Box 26-F
 Wiggins, MS 39577
 (mailing address)

description of formations encountered	from	to
CLAY SAND	0	20
	20	60


WELL LOCATION:
 sec. 34 T. 2 N. R. 11 E.
 3 1/2 miles SE of Wiggins
 (distance) (direction) (nearest town)

WELL PURPOSE: home
 (home, irrigation, municipal, industrial)

- WELL COMPLETION DATA:
- (1) diameter (inches) 2"
 - (2) total depth (feet) 60'
 - (3) static water level (feet) 21' below above top of ground.
 - (4) casing PVC, total
 (material) (depth)
2"
 (size) if telescope see back.
 - (5) screen 5, 55
 (length) (depth to top)
2", PVC underbar
 (size) (material)
 - (6) pump 1, 8
 (HP) (yield gpm)
230
 (type power)
 - (7) electric log no
 (yes or no)
- (organization running log)

(8) how well bottom plugged
2" sand shark

DRILLERS REMARKS:
no tail pipe

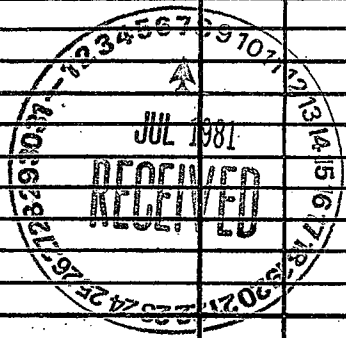

If well telescopes please sketch and show depths.

GROUND LEVEL

		X	

SECTION 34

Please indicate well location X.

ADDITIONAL INFORMATION

If more than one screen, show locations of each on sketch.