

Stone
Cassio
6-3-81

MISSISSIPPI
BOARD OF WATER COMMISSIONERS
416 North State Street
Jackson, Mississippi 39201

WATER WELL DRILLERS LOG
BRADEN PUMP AND WELL SERVICE, INC.

6-3-81

ROUTE 1, BOX 489


Stone

date well completed

SAUCIER, MS 39374


county well located

| LANDOWNER: | description of formations encountered | from | to |
|---|---------------------------------------|---------|----------|
| ORALEE BOGGS P.O. Box 522 | | | |
| Wiggins, MS 39577 (mailing address) | Clay SAND | 0 20 | 20 45 |
| WELL LOCATION: | | | |
| sec. 27 T. 2 N. R. 11 E. 3/4 miles E of Wiggins (distance) (direction) (nearest town) | | | |
| WELL PURPOSE: home (home, irrigation, municipal, industrial) | | | |
| WELL COMPLETION DATA: | | | |
| (1) diameter (inches) 2" | | | |
| (2) total depth (feet) 45 | | | |
| (3) static water level (feet) 21 below top of ground. | | | |
| (4) casing PVC total (material) (depth) | | | |
| 2" if telescope see back. (size) | | | |
| (5) screen 5 40 (length) (depth to top) | | | |
| 2" PVC underbar (size) (material) | | | |
| (6) pump 1/2 4 (HP) (yield gpm) | | | |
| 110 (type power) | | | |
| (7) electric log NO (yes or no) | | | |
| (organization running log) | | | |
| (8) how well bottom plugged 2" sand shark | | | |
| DRILLERS REMARKS: | | | |
| NO tail pipe | | | |

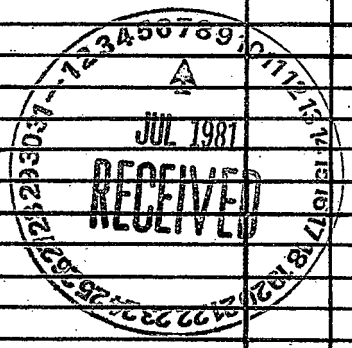

If well telescopes please sketch and show depths.

GROUND LEVEL

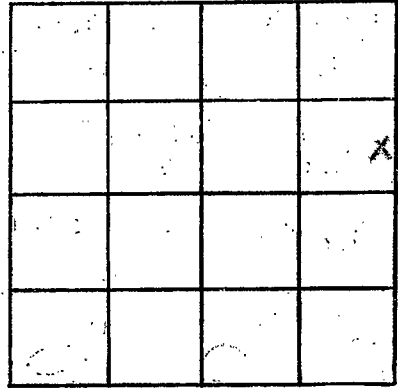

SECTION 27

Please indicate well location X.

ADDITIONAL INFORMATION

If more than one screen, show locations of each on sketch.