

MISSISSIPPI DEPARTMENT OF NATURAL RESOURCES

Bureau of Land and Water Resources

Southport Mall

P.O. Box 10631

Jackson, Mississippi 39209

WATER WELL DRILLERS LOG

Stone
C 2558
7-20-81

July 20 1981 Parnell Anderson Stone  
 date well completed firm name county well located

LANDOWNER: Bobby W. Hunt  
Qt 1  
Wiggins MS 39577  
 (mailing address)

description of formations encountered	from	to
Top soil	0	2
Clay	2	24
Fine sand	24	38
Clay	38	76
Fine sand	76	82
Coarse sand	82	100

WELL LOCATION:  
 sec 32 T 2 N 11 E  
2 miles SE of Wiggins  
 (distance) (direction) (nearest town)

WELL PURPOSE: None  
 (home, irrigation, municipal, industrial)

- WELL COMPLETION DATA:
- (1) diameter (inches) 2"
  - (2) total depth (feet) 100'
  - (3) static water level (feet) 90 below above top of ground.
  - (4) casing PVC 95'  
 (material) (depth)
  - (size) if telescope see back.
  - (5) screen 5' 95'  
 (length) (depth to top)
  - 2" PVC  
 (size) (material)
  - (6) pump 1 14  
 (HP) (yield gpm)
  - Electric  
 (type power)
  - (7) electric log NO  
 (yes or no)

(organization running log)


(8) how well bottom plugged Capped

DRILLERS REMARKS:



If well telescopes please  
sketch and show depths.

GROUND LEVEL

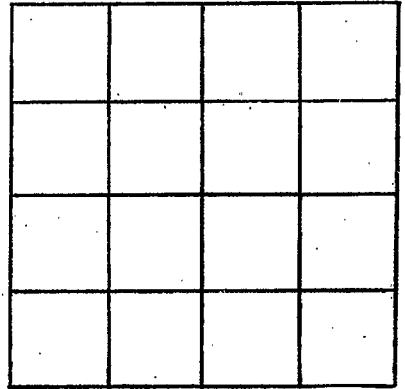

SECTION \_\_\_\_\_

Please indicate well location X.

ADDITIONAL INFORMATION

If more than one screen,  
show locations of each on sketch.