

MISSISSIPPI DEPARTMENT OF NATURAL RESOURCES

Bureau of Land and Water Resources

Southport Mall

P.O. Box 10631

Jackson, Mississippi 39209

WATER WELL DRILLERS LOG

Stone
C 2059
8/8/81

Aug 8 1981 Parnee Anderson Stone Stone
 date well completed firm name county well located

LANDOWNER: Ruby B Joyner
Rt 2
Wiggins, MS 39573
 (mailing address)

description of formations encountered	from	to
<u>Top Soil</u>	<u>0</u>	<u>2</u>
<u>Clay</u>	<u>2</u>	<u>23</u>
<u>Sand</u>	<u>22</u>	<u>60</u>
<u>Clay</u>	<u>60</u>	<u>88</u>
<u>Sand Fine</u>	<u>88</u>	<u>110</u>
<u>Coarse Sand</u>	<u>110</u>	<u>125</u>

WELL LOCATION:
 sec 31 T 2 N R 11 E
2 miles S of Wiggins
 (distance) (direction) (nearest town)

WELL PURPOSE: home
 (home, irrigation, municipal, industrial)

WELL COMPLETION DATA:

(1) diameter (inches) 2"

(2) total depth (feet) 125'

(3) static water level (feet) 60 / below top of ground


(4) casing PVC 120'
 (material) (depth)
 (size) if telescope see back.

(5) screen 5' 120'
 (length) (depth to top)
2" PVC
 (size) (material)

(6) pump 1 11
 (HP) (yield gpm)
Electric
 (type power)

(7) electric log NO
 (yes or no)
 (organization running log)


(8) how well bottom plugged Capped

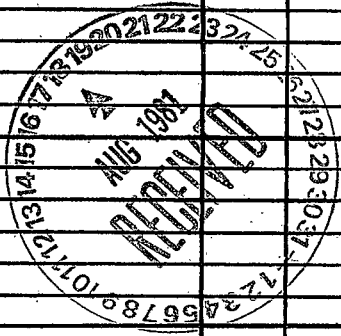

DRILLERS REMARKS:

If well telescopes please sketch and show depths.

GROUND LEVEL

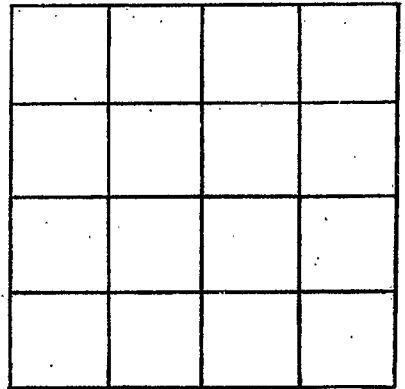

SECTION _____

Please indicate well location X.

ADDITIONAL INFORMATION

If more than one screen,
show locations of each on sketch.