

Stone
 C 2006
 11/3/81

MISSISSIPPI
 BOARD OF WATER COMMISSIONERS
 416 North State Street
 Jackson, Mississippi 39201

WATER WELL DRILLERS LOG

Nov 3 1981 Paul Anderson Stone
 date well completed firm name county well located

LANDOWNER: <u>John Willie</u>	description of formations encountered	from	to
<u>Rt 1 Box 44</u> <u>Wiggins, Ms 39577</u> (mailing address)			
	<u>Top soil</u>	<u>0</u>	<u>2</u>
	<u>Clay</u>	<u>2</u>	<u>19</u>
	<u>Sand</u>	<u>19</u>	<u>32</u>
	<u>Clay</u>	<u>32</u>	<u>66</u>
	<u>Sand with clay</u>	<u>66</u>	<u>100</u>
	<u>sand</u>	<u>100</u>	<u>125</u>

WELL LOCATION:
 sec. 36 T 2 S R. 11 W
1.5 miles E of Wiggins
 (distance) (direction) (nearest town)

WELL PURPOSE: none
 (home, irrigation, municipal, industrial)

- WELL COMPLETION DATA:
- (1) diameter (inches) 125 " 2 "
 - (2) total depth (feet) 125 "
 - (3) static water level (feet) 20 ' below top of ground.
 - (4) casing PVC 120 ' (material) (depth)
 - _____ if telescope see back. (size)
 - (5) screen 5 120 ' (length) (depth to top)
2 " (size) PVC (material)
 - (6) pump 1 11 (HP) (yield gpm)
Electric (type power)
 - (7) electric log No (yes or no)
 - _____ (organization running log)
 - (8) how well bottom plugged Capped

DEPT. OF NATURAL RESOURCES
 BUREAU OF LAND & WATER RESOURCES


DEC 30 1981

RECEIVED

DRILLERS REMARKS:

If well telescopes please
sketch and show depths.

GROUND LEVEL

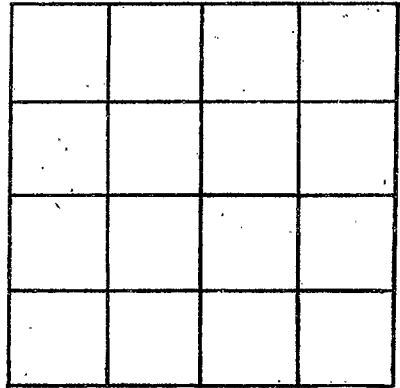

SECTION _____

Please indicate well location X.

ADDITIONAL INFORMATION

If more than one screen,
show locations of each on sketch.