

MISSISSIPPI DEPARTMENT OF NATURAL RESOURCES

Bureau of Land and Water Resources

Southport Mall

P.O. Box 10631

Jackson, Mississippi 39209

WATER WELL DRILLERS LOG

Stone  
C 2065

1-15  
date well completed

1982 Frank Pries  
firm name

Stone  
county well located

LANDOWNER:	description of formations encountered	from	to
<u>Houston Denny</u>	<u>Top Soil</u>	<u>0</u>	<u>3</u>
(mailing address)	<u>Clay</u>	<u>3</u>	<u>17</u>
WELL LOCATION:	<u>Coarse sand</u>	<u>17</u>	<u>65</u>
sec <u>25 T 2 R 11 S 1 E</u>			
<u>1</u> miles <u>E</u> of <u>Likeaway</u>			
(distance) (direction) (nearest town)			
WELL PURPOSE: <u>HOME</u>			
(home, irrigation, municipal, industrial)			
WELL COMPLETION DATA:			
(1) diameter (inches) <u>2"</u>			
(2) total depth (feet) <u>65'</u>			
(3) static water level (feet) <u>43</u> below top of ground.			
(4) casing <u>Plastic</u> , <u>60'</u> (material) (depth)			
_____ if telescope see back. (size)			
(5) screen <u>5'</u> , <u>60'</u> (length) (depth to top)			
<u>2"</u> , <u>Plastic</u> (size) (material)			
(6) pump <u>1</u> (HP) <u>9</u> (yield gpm)			
<u>Elect</u> (type power)			
(7) electric log <u>no</u> (yes or no)			
_____ (organization running log)			
(8) how well bottom plugged <u>Capped</u>			
DRILLERS REMARKS:			


DEPT. OF NATURAL RESOURCES  
BUREAU OF LAND & WATER RESOURCES

FEB - 8 1982

RECEIVED

If well telescopes please sketch and show depths.

GROUND LEVEL

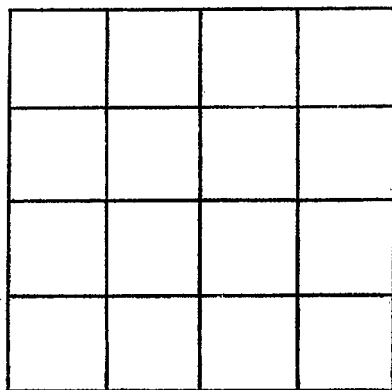

SECTION \_\_\_\_\_

Please indicate well location X.

ADDITIONAL INFORMATION

If more than one screen, show locations of each on sketch.