

MISSISSIPPI DEPARTMENT OF NATURAL RESOURCES

Bureau of Land and Water Resources

Southport Mall

P.O. Box 10631

Jackson, Mississippi 39209

WATER WELL DRILLERS LOG

Stone
 Coahoma

5-19-82
 date well completed

Frank Price
 firm name

Stone
 county well located

LANDOWNER:
 Randy Prescott
 (mailing address)

description of formations encountered	from	to
Top Soil	0	3
Loamy Clay	3	12
Coarse Sand	12	42

WELL LOCATION:
 sec. 4 T 2 N R 11 W
 2 miles E of Flint Creek
 (distance) (direction) (nearest town)

WELL PURPOSE: HOME
 (home, irrigation, municipal, industrial)

WELL COMPLETION DATA:

(1) diameter (inches) 2"

(2) total depth (feet) 42'

(3) static water level (feet) 28' below top of ground.

(4) casing Plastic 37' (material) (depth)

if telescope see back.

(5) screen 5" (length) 37' (depth to top)

2" Plastic (size) (material)

(6) pump 1 (HP) 8 (yield gpm)

Elect (type power)

(7) electric log NO (yes or no)

(organization running log)

(8) how well bottom plugged
 Capped

DRILLERS REMARKS:


DEPT. OF NATURAL RESOURCES
 BUREAU OF LAND & WATER RESOURCES

JUN 15 1982

RECEIVED

If well telescopes please sketch and show depths.

GROUND LEVEL

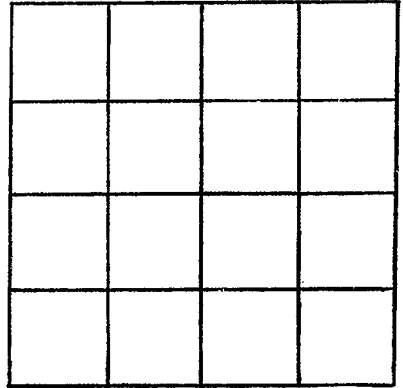

SECTION _____

Please indicate well location X.

ADDITIONAL INFORMATION

If more than one screen,
show locations of each on sketch.