

MISSISSIPPI DEPARTMENT OF NATURAL RESOURCES

Bureau of Land and Water Resources

Southport Mall

P.O. Box 10631

Jackson, Mississippi 39209

WATER WELL DRILLERS LOG

Stone
C2008

7-23 1982
date well completed

Frank Price
firm name

Stone
county well located

LANDOWNER:	description of formations encountered	from	to
Steve Prescott	Top Soil	0	3
(mailing address)	Red Sand	3	23
WELL LOCATION:	Coarse Sand	23	65
sec. <u>3</u> T <u>2</u> N R <u>11</u> E S W <u>2</u> miles <u>E</u> of <u>FC. Reservoir</u> (distance) (direction) (nearest town)			
WELL PURPOSE: <u>HOME</u> (home, irrigation, municipal, industrial)			
WELL COMPLETION DATA:			
(1) diameter (inches) <u>2"</u>			
(2) total depth (feet) <u>65'</u>			
(3) static water level (feet) <u>36</u> below top of ground. above			
(4) casing <u>Plastic</u> , <u>60'</u> (material) (depth)			
<u> </u> if telescope see back. (size)			
(5) screen <u>5'</u> , <u>60'</u> (length) (depth to top)			
<u>2"</u> , <u>Plastic</u> (size) (material)			
(6) pump <u>1</u> <u>8</u> (HP) (yield gpm)			
<u>Elect</u> (type power)			
(7) electric log <u>no</u> (yes or no)			
<u> </u> (organization running log)			
(8) how well bottom plugged <u>Backwash Valve</u>			
DRILLERS REMARKS:			


DEPT. OF NATURAL RESOURCES
BUREAU OF LAND & WATER RESOURCES

AUG 11 1982

RECEIVED

If well telescopes please sketch and show depths.

GROUND LEVEL

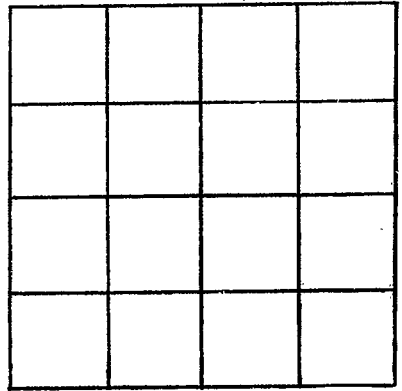

SECTION _____

Please indicate well location X.

ADDITIONAL INFORMATION

If more than one screen, show locations of each on sketch.