

MISSISSIPPI DEPARTMENT OF NATURAL RESOURCES

Bureau of Land and Water Resources

Southport Mall

P.O. Box 10631

Jackson, Mississippi 39209

WATER WELL DRILLERS LOG

Stone
C2000

7-31 date well completed

Frank Price firm name

Stone county well located

LANDOWNER:

Barbara Marshall

(mailing address)

WELL LOCATION:

sec 34 T 2 S R 11 E W
3 miles E of Wiggins
(distance) (direction) (nearest town)

WELL PURPOSE:

HOME (home, irrigation, municipal, industrial)

WELL COMPLETION DATA:

- (1) diameter (inches) 2"
- (2) total depth (feet) 112'
- (3) static water level (feet) 42 below top of ground.
- (4) casing Plastic, 107' (material) (depth)
- (5) screen 5' 107' (length) (depth to top)
2" Plastic (size) (material)
- (6) pump 1 10 (HP) (yield gpm)
E lect (type power)
- (7) electric log no (yes or no)

(organization running log)

- (8) how well bottom plugged Back wash valve

DRILLERS REMARKS:

description of formations encountered

from to

Top Soil	0	2
Red Clay	2	18
Fine Sand	18	24
Clay	24	30
Coarse Sand	30	59
Clay	59	65
Coarse Sand	65	112


DEPT. OF NATURAL RESOURCES
BUREAU OF LAND & WATER RESOURCES

AUG 11 1982

RECEIVED

If well telescopes please
sketch and show depths.

GROUND LEVEL

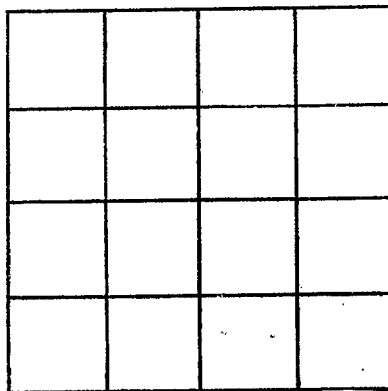

SECTION _____

Please indicate well location X.

ADDITIONAL INFORMATION

If more than one screen,
show locations of each on sketch.