

MISSISSIPPI DEPARTMENT OF NATURAL RESOURCES

Bureau of Land and Water Resources

Southport Mall

P.O. Box 10631

Jackson, Mississippi 39209

WATER WELL DRILLERS LOG

Stone
C 2071

9-24
date well completed

1982 Frank Prie
firm name

Stone
county well located

LANDOWNER:	description of formations encountered	from	to
Fred Waltenberg	Top Soil	0	2
(mailing address)	Clay	2	22
WELL LOCATION:	Coarse Sand	22	40
sec 26 T-2 R-11 S Lake-O-way			
(distance) miles (direction) of (nearest town)			
WELL PURPOSE: HOME			
(home, irrigation, municipal, industrial)			
WELL COMPLETION DATA:			
(1) diameter (inches) 2"			
(2) total depth (feet) 40'			
(3) static water level (feet) 9' below top of ground.			
(4) casing Plastic, 35'			
(material) (depth)			
(size) if telescope see back.			
(5) screen 5' 35'			
(length) (depth to top)			
2" Plastic			
(size) (material)			
(6) pump 1/2 6			
(HP) (yield gpm)			
Elect			
(type power)			
(7) electric log no			
(yes or no)			
(organization running log)			
(8) how well bottom plugged			
Capped			
DRILLERS REMARKS:			


DEPT. OF NATURAL RESOURCES
OF LAND & WATER RESOURCES

OCT - 5 1982

RECEIVED

If well telescopes please sketch and show depths.

GROUND LEVEL

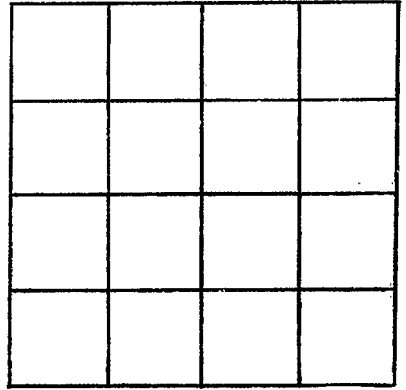

SECTION _____

Please indicate well location X.

ADDITIONAL INFORMATION

If more than one screen, show locations of each on sketch.