

MISSISSIPPI DEPARTMENT OF NATURAL RESOURCES

Bureau of Land and Water Resources

Southport Mall

P.O. Box 10631

Jackson, Mississippi 39209

WATER WELL DRILLERS LOG

Stone
ec
2072

5-5-83 1983 Frank Price Stone  
 date well completed firm name county well located

LANDOWNER:	description of formations encountered	from	to
<u>Willard Ladner</u>	<u>Top Soil</u>	<u>0</u>	<u>2</u>
(mailing address)	<u>Sand</u>	<u>2</u>	<u>45"</u>
WELL LOCATION:			
sec <u>26</u> T <u>2</u> N R <u>11</u> E			
<u>Sak-O-way</u>			
(distance) (direction) (nearest town)			
WELL PURPOSE: <u>HOME</u>			
(home, irrigation, municipal, industrial)			
WELL COMPLETION DATA:			
(1) diameter (inches) <u>3"</u>			
(2) total depth (feet) <u>45'</u>			
(3) static water level (feet) <u>12</u> below top of ground.			
(4) casing <u>Plastic</u> <u>40'</u> (material) (depth)			
(size) If telescope see back.			
(5) screen <u>3'</u> <u>40'</u> (length) (depth to top)			
<u>3"</u> <u>Plastic</u> (size) (material)			
(6) pump <u>1/2</u> <u>7</u> (HP) (yield gpm)			
<u>Elect</u> (type power)			
(7) electric log <u>no</u> (yes or no)			
(organization running log)			
(8) how well bottom plugged <u>Capped</u>			
DRILLERS REMARKS:			


DEPT. OF NATURAL RESOURCES  
 BUREAU OF LAND & WATER RESOURCES

JUN 20 1983

RECEIVED

If well telescopes please sketch and show depths.

GROUND LEVEL

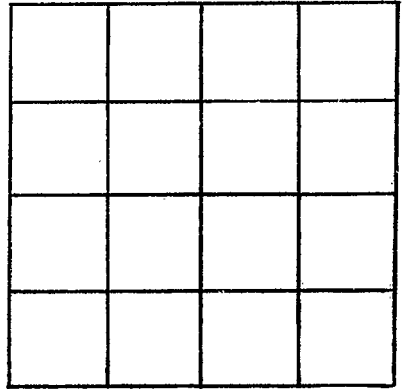

SECTION \_\_\_\_\_

Please indicate well location X.

ADDITIONAL INFORMATION

If more than one screen, show locations of each on sketch.