

MISSISSIPPI DEPARTMENT OF NATURAL RESOURCES

Bureau of Land and Water Resources

Southport Mall

P.O. Box 10631

Jackson, Mississippi 39209

WATER WELL DRILLERS LOG

Stone
e
2073

9-7-83 1983 Frank Price Stone
 date well completed firm name county well located

LANDOWNER:
 Odell B Ireland
 (mailing address)

WELL LOCATION:
 sec. 33 T. 2 N. R. 11 E. S. W.
 1 1/2 miles S E of Wiggins
 (distance) (direction) (nearest town)

WELL PURPOSE: HOME
 (home, irrigation, municipal, industrial)

WELL COMPLETION DATA:

(1) diameter (inches) 4"

(2) total depth (feet) 80'

(3) static water level (feet) 40' below top of ground.

(4) casing Plastic 75' (material) (depth)

_____ If telescope see back. (size)

(5) screen 5' 75' (length) (depth to top)

4" Plastic (size) (material)

(6) pump 1 30 (HP) (yield gpm)

Elect (type power)

(7) electric log No (yes or no)

(organization running log)

(8) how well bottom plugged
 O.W.V.


DRILLERS REMARKS:

description of formations encountered	from	to
Top Soil	0	3
Red Clay	3	21
Sandy Clay	21	36
Hard Sand	36	69
Course 11	69	80

DEPT OF NATURAL RESOURCES
 BUREAU OF LAND & WATER RESOURCES
 SEP 12 1983
 RECEIVED

If well telescopes please sketch and show depths.

GROUND LEVEL

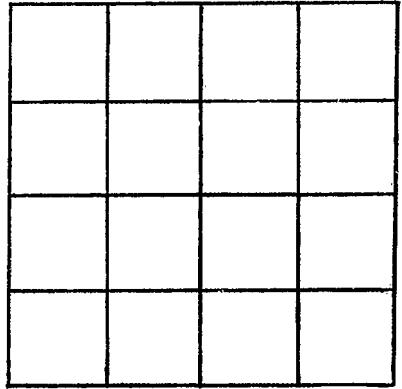

SECTION _____

Please indicate well location X.

ADDITIONAL INFORMATION

If more than one screen,
show locations of each on sketch.