

MISSISSIPPI DEPARTMENT OF NATURAL RESOURCES

Bureau of Land and Water Resources

Southport Mall

P.O. Box 10631

Jackson, Mississippi 39209

WATER WELL DRILLERS LOG

Stone
C
2014

8-12 1983
date well completed

Frank Dice
firm name

Stone
county well located

LANDOWNER:	description of formations encountered	from	to
Brently Baker	Top Soil	0	2
(mailing address)	Red Clay	2	12
WELL LOCATION:	White Clay	12	80
sec 27 T 2 N R 11 E S W	Fine Sand	80	87
2 miles E of Wiggins	Coarse Sand	87	98
(distance) (direction) (nearest town)			
WELL PURPOSE: HOME			
(home, irrigation, municipal, industrial)			
WELL COMPLETION DATA:			
(1) diameter (inches) 2"			
(2) total depth (feet) 98'			
(3) static water level (feet) 60' below top of ground.			
(4) casing Plastic 93' (material) (depth)			
(size) if telescope see back.			
(5) screen 5' 93' (length) (depth to top)			
2" Plastic (size) (material)			
(6) pump 1 (HP) 9 (yield gpm)			
Elect (type power)			
(7) electric log no (yes or no)			
(organization running log)			
(8) how well bottom plugged B.W.V.			
DRILLERS REMARKS:			


DEPT. OF NATURAL RESOURCES
BUREAU OF LAND & WATER RESOURCES

SEP 12 1983

RECEIVED

If well telescopes please sketch and show depths.

GROUND LEVEL

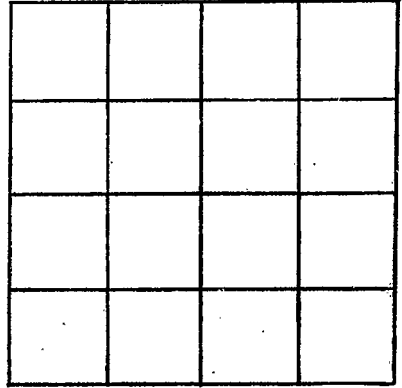

SECTION _____

Please indicate well location X.

ADDITIONAL INFORMATION

If more than one screen,
show locations of each on sketch.