

MISSISSIPPI DEPARTMENT OF NATURAL RESOURCES

Bureau of Land and Water Resources

Southport Mall

P.O. Box 10631

Jackson, Mississippi 39209

WATER WELL DRILLERS LOG

Stone  
C  
2078

8-12 1983  
 date well completed

Frank Price  
 firm name

Stone  
 county well located

LANDOWNER:

Pinco Inc

description of formations encountered

from

to

Top Soil	0	3
Red Clay	7	20
Sandy Clay	20	35
Hard Sand	35	90
Coarse Sand	70	112

(mailing address)

WELL LOCATION:

sec 30 T 2 N R 11 E  
 S W  
 Wiggins  
 (distance) (direction) (nearest town)

WELL PURPOSE: Industrial  
 (home, irrigation, municipal, industrial)

WELL COMPLETION DATA:

- (1) diameter (inches) 4"
- (2) total depth (feet) 112'
- (3) static water level (feet) 36 below above top of ground.
- (4) casing Plastic, 107'  
 (material) (depth)  
 (size) if telescope see back.
- (5) screen 5', 107'  
 (length) (depth to top)  
4", Plastic  
 (size) (material)
- (6) pump 1 30  
 (HP) (yield gpm)  
Elect  
 (type power)
- (7) electric log NO  
 (yes or no)

(organization running log)

(8) how well bottom plugged  
B.W.V.

DRILLERS REMARKS:


DEPT. OF NATURAL RESOURCES  
 BUREAU OF LAND & WATER RESOURCES

SEP 12 1983

RECEIVED

If well telescopes please sketch and show depths.

GROUND LEVEL

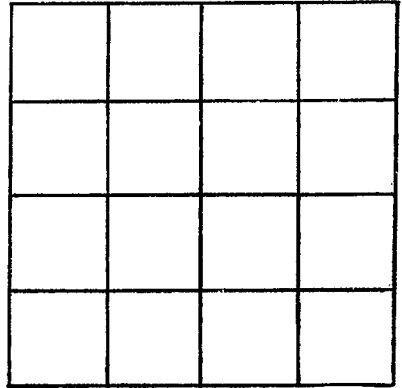

SECTION \_\_\_\_\_

Please indicate well location X.

ADDITIONAL INFORMATION

If more than one screen,  
show locations of each on sketch.