

MISSISSIPPI DEPARTMENT OF NATURAL RESOURCES

Bureau of Land and Water Resources

Southport Mall

P.O. Box 10631

Jackson, Mississippi 39209

WATER WELL DRILLERS LOG

Stone
C
207A

9-21-83
 date well completed

Frank Pries
 firm name

Stone
 county well located

LANDOWNER:
Gene Alexander
 (mailing address)

description of formations encountered	from	to
<u>Top Soil</u>	<u>0</u>	<u>2</u>
<u>Red Clay</u>	<u>2</u>	<u>35</u>
<u>Fine Sand</u>	<u>35</u>	<u>80</u>
<u>Coarse Sand</u>	<u>80</u>	<u>97</u>

WELL LOCATION:
 sec. 14 T. 2 N. R. 11 E.
2 miles N of Whitecross
 (distance) (direction) (nearest town)

WELL PURPOSE: HOME
 (home, irrigation, municipal, industrial)

WELL COMPLETION DATA:

(1) diameter (inches) 2"

(2) total depth (feet) 97'

(3) static water level (feet) 45' below top of ground.

(4) casing Plastic 92'
 (material) (depth)

_____ If telescope see back.
 (size)

(5) screen 5' 92'
 (length) (depth to top)

2" Plastic
 (size) (material)

(6) pump 1 9
 (HP) (yield gpm)

Elect
 (type power)

(7) electric log no
 (yes or no)

_____ (organization running log)

(8) how well bottom plugged D.W.V.

DRILLERS REMARKS:


DEPT. OF NATURAL RESOURCES
 BUREAU OF LAND & WATER RESOURCES

OCT 3 1983

RECEIVED

If well telescopes please sketch and show depths.

GROUND LEVEL

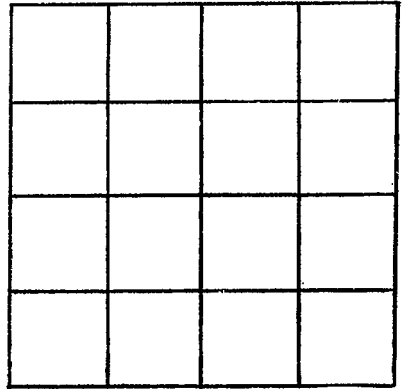

SECTION _____

Please indicate well location X.

ADDITIONAL INFORMATION

If more than one screen, show locations of each on sketch.