

MISSISSIPPI DEPARTMENT OF NATURAL RESOURCES

Bureau of Land and Water Resources

Southport Mall

P.O. Box 10631

Jackson, Mississippi 39209

WATER WELL DRILLERS LOG

Stone
C 2080

9-21 1983
 date well completed

Frank P. Stone
 firm name

Stone
 county well located

LANDOWNER:
Roger White
 (mailing address)

WELL LOCATION:
 sec. 25 T. 2 N. R. 11 E. S. 5 W.
Whites Crossing
 (distance) miles (direction) of (nearest town)

WELL PURPOSE: HOME
 (home, irrigation, municipal, industrial)

WELL COMPLETION DATA:

(1) diameter (inches) 2"

(2) total depth (feet) 115'

(3) static water level (feet) 58' below top of ground.

(4) casing Plastic, 110' (material) (depth)
 (size) if telescope see back.

(5) screen 5", 110' (length) (depth to top)
2", Plastic (size) (material)

(6) pump 1, 10 (HP) (yield gpm)
Elect (type power)

(7) electric log no (yes or no)
 (organization running log)

description of formations encountered	from	to
<u>Top Soil</u>	<u>0</u>	<u>2</u>
<u>Sandy Clay</u>	<u>2</u>	<u>12</u>
<u>Fin Sand</u>	<u>12</u>	<u>45</u>
<u>Clay</u>	<u>45</u>	<u>70</u>
<u>Coarse Sand</u>	<u>70</u>	<u>115</u>

(8) how well bottom plugged
B. W. V.

DRILLERS REMARKS:


DEPT. OF NATURAL RESOURCES
 BUREAU OF LAND & WATER RESOURCES

OCT 3 1983

RECEIVED

If well telescopes please sketch and show depths.

GROUND LEVEL

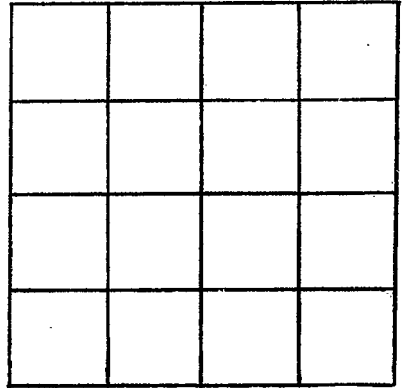

SECTION _____

Please indicate well location X.

ADDITIONAL INFORMATION

If more than one screen,
show locations of each on sketch.