

MISSISSIPPI DEPARTMENT OF NATURAL RESOURCES

Bureau of Land and Water Resources

Southport Mall

P.O. Box 10631

Jackson, Mississippi 39209

WATER WELL DRILLERS LOG

Stone
C
2081

3-3-84 date well completed

Frank E. Pisci firm name

Stone county well located

LANDOWNER:
Odin Husband
 (mailing address)

description of formations encountered	from	to
<u>Top Soil</u>	<u>0</u>	<u>3</u>
<u>Red Clay</u>	<u>3</u>	<u>18</u>
<u>Shil Sand</u>	<u>18</u>	<u>29</u>
<u>Clay</u>	<u>29</u>	<u>60</u>
<u>Coarse Sand</u>	<u>60</u>	<u>82</u>

WELL LOCATION:
 sec. 36 T 2 N R. 11 E
1 3/4 miles S of White Cross
 (distance) (direction) (nearest town)

WELL PURPOSE: HOME
 (home, irrigation, municipal, industrial)

- WELL COMPLETION DATA:
- (1) diameter (inches) 2"
 - (2) total depth (feet) 82'
 - (3) static water level (feet) 40 below top of ground.
 - (4) casing PVC, 77' (material) (depth)
 (size) if telescope see back.
 - (5) screen 5', 77' (length) (depth to top)
2, PVC (size) (material)
 - (6) pump 1 (HP) 12 (yield gpm)
Elect (type power)
 - (7) electric log no (yes or no)

(organization running log)

(8) how well bottom plugged B.W.V.

DRILLERS REMARKS:


DEPT. OF NATURAL RESOURCES
 BUREAU OF LAND & WATER RESOURCES

APR 10 1984

RECEIVED

If well telescopes please sketch and show depths.

GROUND LEVEL

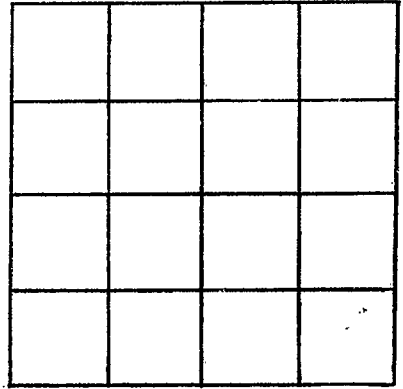

SECTION _____

Please indicate well location X.

ADDITIONAL INFORMATION

If more than one screen, show locations of each on sketch.