

MISSISSIPPI DEPARTMENT OF NATURAL RESOURCES

Bureau of Land and Water Resources

Southport Mall

P.O. Box 10631

Jackson, Mississippi 39209

WATER WELL DRILLERS LOG

STONE  
C  
2083

7-3 1984  
date well completed

Frank Price  
firm name

Stone  
county well located

LANDOWNER:  
Dennis Fore  
(mailing address)

description of formations encountered	from	to
Top Soil	0	2
Clay	2	78
Course Sand	78	95

WELL LOCATION:  
sec 28 T 2 N R 11 E  
S W  
1 miles E of Wiggins  
(distance) (direction) (nearest town)

WELL PURPOSE: HOME  
(home, irrigation, municipal, industrial)

WELL COMPLETION DATA:

(1) diameter (inches) 2"

(2) total depth (feet) 92'

(3) static water level (feet) 20' below top of ground.

(4) casing PVC, 87' (material) (depth)  
(size) if telescope see back.

(5) screen 5' 87' (length) (depth to top)  
2" PVC (size) (material)

(6) pump 1 10 (HP) (yield gpm)  
Elect (type power)

(7) electric log NO (yes or no)

(organization running log)

(8) how well bottom plugged B W V

DRILLERS REMARKS:


DEPT. OF NATURAL RESOURCES  
BUREAU OF LAND & WATER RESOURCES

SEP - 7 1984

RECEIVED

If well telescopes please  
sketch and show depths.

GROUND LEVEL

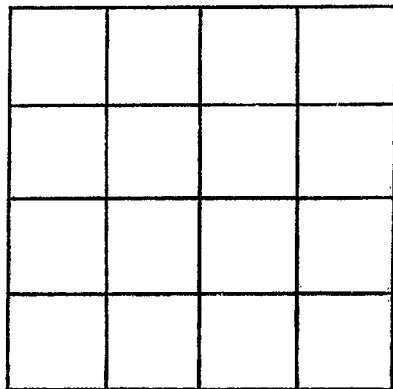

SECTION \_\_\_\_\_

Please indicate well location X.

ADDITIONAL INFORMATION

If more than one screen,  
show locations of each on sketch.