

MISSISSIPPI DEPARTMENT OF NATURAL RESOURCES

Bureau of Land and Water Resources

Southport Mall

P.O. Box 10631

Jackson, Mississippi 39209

WATER WELL DRILLERS LOG

STONE  
C  
2088

11-8 1984 Frank Price Stone  
date well completed firm name county well located

LANDOWNER:  
W.D. Blackwell  
(mailing address)

WELL LOCATION:  
sec. 3 T. 3 S. R. 11  
1 1/2 miles W of Bicy Level  
(distance) (direction) (nearest town)

WELL PURPOSE: HOME  
(home, irrigation, municipal, industrial)

WELL COMPLETION DATA:

(1) diameter (inches) 2

(2) total depth (feet) 146

(3) static water level (feet) 60' below top of ground

(4) casing PVC 241 (material) (depth)  
2 (size) if telescope see back.

(5) screen 5" 141 (length) (depth to top)  
2" PVC (size) (material)

(6) pump 1 (HP) 8 (yield gpm)  
Elect (type power)

(7) electric log no (yes or no)  
(organization running log)

(8) how well bottom plugged SWV

description of formations encountered	from	to
Top Soil	0	2
Clay	2	65
Fine Sand	65	90
Clay	90	115
Coarse Sand	115	146

DEPT. OF NATURAL RESOURCES  
BUREAU OF LAND & WATER RESOURCES


DEC - 7 1984

RECEIVED

DRILLERS REMARKS:

If well telescopes please sketch and show depths.

GROUND LEVEL

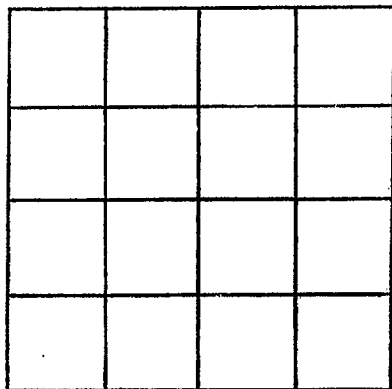

SECTION \_\_\_\_\_

Please indicate well location X.

ADDITIONAL INFORMATION

If more than one screen, show locations of each on sketch.