

MISSISSIPPI DEPARTMENT OF NATURAL RESOURCES

Bureau of Land and Water Resources

Southport Mall

P.O. Box 10631

Jackson, Mississippi 39209

WATER WELL DRILLERS LOG

STONE  
C2087

11-14  
date well completed

Frank Davis  
firm name

Stone  
county well located

LANDOWNER:

Eva Baker

(mailing address)

WELL LOCATION:

sec. 35 T. 2 N R. 11 E  
1 1/2 miles S of Whites Crossing  
(distance) (direction) (nearest town)

WELL PURPOSE: HOME  
(home, irrigation, municipal, industrial)

WELL COMPLETION DATA:

- (1) diameter (inches) 2"
- (2) total depth (feet) 100'
- (3) static water level (feet) 40' below top of ground.
- (4) casing PVC 95'-1'  
(material) (depth)
- (5) screen 5' 95'-1'  
(length) (depth to top)
- 2" PVC  
(size) (material)
- (6) pump 1 1/2 HP 12  
(HP) (yield gpm)
- Elect  
(type power)
- (7) electric log NO  
(yes or no)

(organization running log)

(8) how well bottom plugged  
B W V

DRILLERS REMARKS:

description of formations encountered

from to

Top Soil 0 1

Red Clay 1 35'

Pin Sand 35-85'

Coarse Sand 85-100'


DEPT. OF NATURAL RESOURCES  
BUREAU OF LAND & WATER RESOURCES

DEC - 7 1984

RECEIVED

If well telescopes please sketch and show depths.

GROUND LEVEL

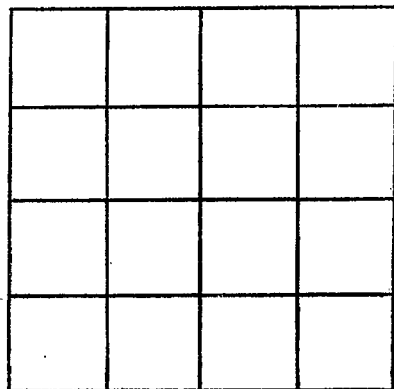

SECTION \_\_\_\_\_

Please indicate well location X.

ADDITIONAL INFORMATION

If more than one screen,  
show locations of each on sketch.