

MISSISSIPPI DEPARTMENT OF NATURAL RESOURCES

Bureau of Land and Water Resources

Southport Mall

P.O. Box 10631

Jackson, Mississippi 39209

WATER WELL DRILLERS LOG

Stone  
C 2070  
5-1-85

5-1

1985

Frank Price

Stone

date well completed

firm name

county well located

LANDOWNER:

George Pearson

(mailing address)

WELL LOCATION:

sec. 28 T 2 S R 11 W  
1 1/2 miles E of Wiggins  
(distance) (direction) (nearest town)

WELL PURPOSE: HOME  
(home, irrigation, municipal, industrial)

WELL COMPLETION DATA:

- (1) diameter (inches) 2"
- (2) total depth (feet) 100'
- (3) static water level (feet) 40' below top of ground.
- (4) casing PVC, 95'  
(material) (depth)
- (size) If telescope see back.
- (5) screen 5' 95'  
(length) (depth to top)
- 2" PVC  
(size) (material)
- (6) pump 1 (HP) 8 (yield gpm)
- Elect  
(type power)
- (7) electric log no  
(yes or no)

(organization running log)

(8) how well bottom plugged

BWV


DRILLERS REMARKS:

description of formations encountered

from

to


Top Soil	0	1
Red clay	1	35
medium sand	35	50
clay	50	70
coarse sand	70	100

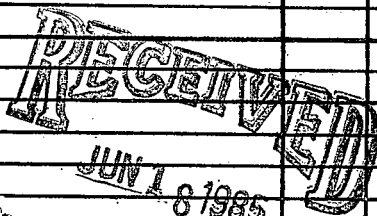

Department of Natural Resources  
Bureau of Land & Water Resources

If well telescopes please sketch and show depths.

GROUND LEVEL

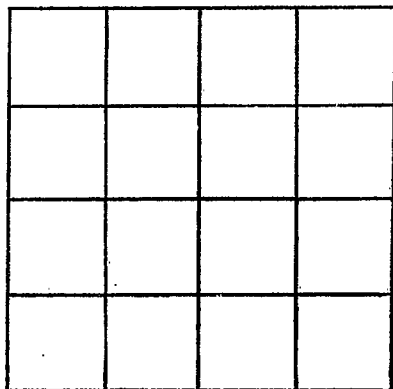

SECTION \_\_\_\_\_

Please indicate well location X.

ADDITIONAL INFORMATION

If more than one screen, show locations of each on sketch.