

MISSISSIPPI DEPARTMENT OF NATURAL RESOURCES

Bureau of Land and Water Resources

Southport Mall

P.O. Box 10631

Jackson, Mississippi 39209

WATER WELL DRILLERS LOG

Stone  
C 2091  
4-25-85

4-25-85 date well completed 1985 Frank Price firm name Stone county well located

LANDOWNER:  
Johnny McCann  
(mailing address)

WELL LOCATION:  
sec. 29 T. 2 N. R. 11 E. S. 5 W.  
1/2 miles F of Wiggins  
(distance) (direction) (nearest town)

WELL PURPOSE: HOME  
(home, irrigation, municipal, industrial)

WELL COMPLETION DATA:

(1) diameter (inches) 2"

(2) total depth (feet) 97'

(3) static water level (feet) 40' below top of ground.

(4) casing PVC, 92"  
(material) (depth)  
(size) if telescope see back.

(5) screen 5' 92'  
(length) (depth to top)  
2" PVC  
(size) (material)

(6) pump 1 10  
(HP) (yield gpm)  
Elect  
(type power)

(7) electric log NO  
(yes or no)  
(organization running log)

(8) how well bottom plugged  
B W V

description of formations encountered	from	to
Top Soil	0	2
Red Clay	2	25
Fine Sand	25	42
Clay	42	82
Coarse Sand	82	97


DRILLERS REMARKS:

RECEIVED  
JUN 18 1985

Department of Natural Resources  
Bureau of Land & Water Resources

If well telescopes please  
sketch and show depths.

GROUND LEVEL

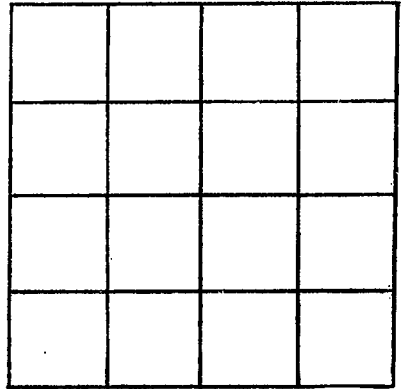

SECTION \_\_\_\_\_

Please indicate well location X.

ADDITIONAL INFORMATION

If more than one screen,  
show locations of each on sketch.