

MISSISSIPPI DEPARTMENT OF NATURAL RESOURCES

Bureau of Land and Water Resources

Southport Mall

P.O. Box 10631

Jackson, Mississippi 39209

WATER WELL DRILLERS LOG

STONE
C 2074

2-28-86
date well completed

86 FRANK PRICE
firm name

Stone
county well located


LANDOWNER:	description of formations encountered	from	to
Stephen Restuarant wanda & stephen's (mailing address)			
WELL LOCATION:	Red clay	3	24 24
sec 31 T 2 N R 11 E S W 1 1/2 miles S of WIGGINS (distance) (direction) (nearest town)	Fine Sand	24	90
WELL PURPOSE: HOME (home, irrigation, municipal, industrial)	Course Sand	90	120
WELL COMPLETION DATA:			
(1) diameter (inches) 2"			
(2) total depth (feet) 120'			
(3) static water level (feet) 50' below top of ground.			
(4) casing PVC 115' (material) (depth)			
(size) If telescope see back.			
(5) screen 5' 115' (length) (depth to top)			
2" PVC (size) (material)			
(6) pump 1 13 (HP) (yield gpm)			
Elect. (type power)			
(7) electric log NO (yes or no)			
(organization running log)			
(8) how well bottom plugged B.W.V.			
DRILLERS REMARKS:			

RECEIVED
MAY 18 1986

Department of Natural Resources
Bureau of Land and Water Resources

If well telescopes please sketch and show depths.

GROUND LEVEL

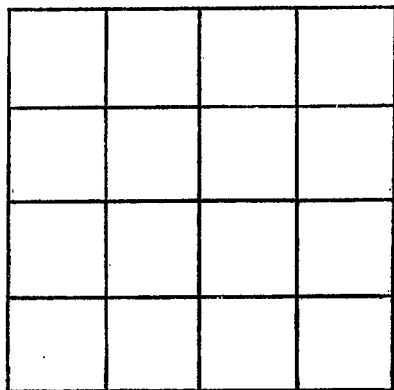

SECTION _____

Please indicate well location X.

ADDITIONAL INFORMATION

If more than one screen,
show locations of each on sketch.